


Section 26 Township 14 Range 13-W

Well No. #9 Letsch

Company Texon

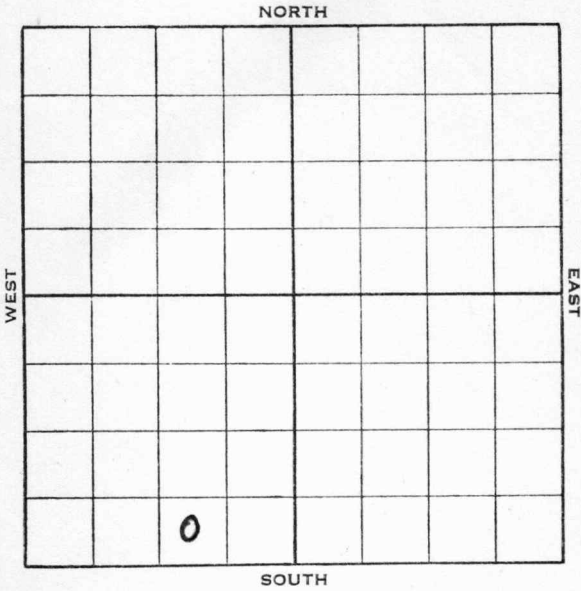

Sec. 26 Twp. 14 R. 13-W

Well No. #9 Letsch Farm

Texon Company


 Ft. from N. Line

330 Ft. from S. Line

990 Ft. from E. Line

 Ft. from W. Line

Elev. 1691

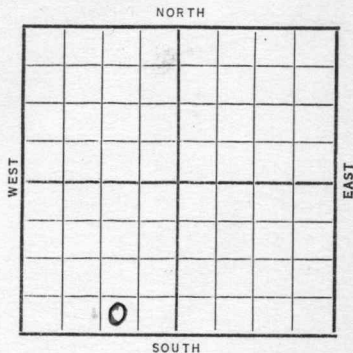

| Date | REPORT |
|-------|------------------------------------|
| 1938 | |
| 10/19 | Cellar. |
| 10/28 | R U R |
| 11/4 | 10" - 316'. Dlg. 1800'. |
| 11/12 | Lans. 2814'. T. D. 2835'. |
| | 7" - 2828'. RUST. |
| 11/15 | T.D. 2867 Pay 2840 1600' OIH (Tel) |
| 11/22 | 7" - 2828'. |
| | Lans. 2814'. |
| | T. D. 2875'. |
| | 7000 acid. |
| | Pump 830 bbls. 8 hrs. |
| | Potential 2491 bbls. |
| | COMPLETED |

Russell

KANSAS

Map No. _____ Sec. 26 Twp. 14 R. 13W

Well No. 9 Letsch

Texon

Company

Contractor

FIRST REPORT

SW ~~SE~~ SW

_____ Ft. from N. Line

330 Ft. from S. Line

990 Ft. from E. Line

_____ Ft. from W. Line

SECTION PLAT

| | | | |
|--|--|--|--|
| | | | |
| | | | |
| | | | |
| | | | |

Location _____

Rig up _____

Drilling and Remarks:

Cellar

RECORD

Cased _____ in., _____ ft.

Sand _____

Gas _____

Oil _____

Total Depth _____

PRODUCTION

1st 24 hrs. Nat. _____

1st 24 hrs. after shot _____

Gas _____ Cu. Ft.

Dry Hole _____

Abandoned _____

Date

OCT 19 1938 19

H. D. Hatfield

Scout

Russell **KANSAS**

Map No. 72 Sec. 26 Twp. 14 R. 13W

Well No. 9 Letsch

Texon

Company

Contractor

COMPLETED

SW SE SW

_____ Ft. from N. Line

330 Ft. from S. Line

990 Ft. from E. Line

_____ Ft. from W. Line

SECTION PLAT

| | | | |
|--|---|--|--|
| | | | |
| | | | |
| | | | |
| | 0 | | |

Location _____

Rig up _____

Drilling and Remarks:

7000 acid.

Pump 830/8 hrs

POT 2491

RECORD

Cased 7 in., 2828 ft.

Sand LENS 2814

Gas _____

Oil _____

Total Depth 2875

PRODUCTION

1st 24 hrs. Nat. _____

1st 24 hrs. after shot _____

Gas _____ Cu. Ft.

Dry Hole _____

Abandoned _____

Date

NOV 22 1938

19

H. D. Hatfield Scout