


Section 26 Township 16 Range 13-W

Well No. #5 Kultgen

Company Stanolind

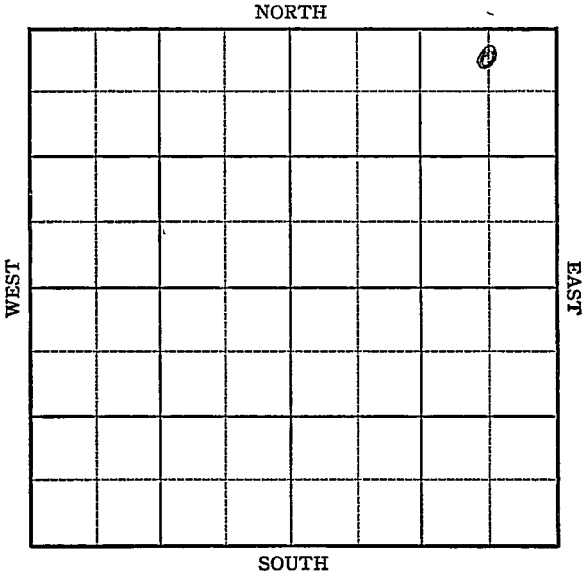

Sec. 26 Twp. 16 R. 13-W

Well No. #5 Kultger Farm

Stanolind Company

(Trapp)


330 Ft. from N. Line

_____ Ft. from S. Line

660 Ft. from E. Line

_____ Ft. from W. Line

Elev. 1944

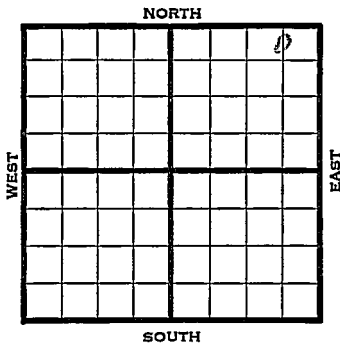

REPORT	
1941	
11/10	Location
11/26	Rotary.
12/4	8" - 253' Drlg. 1240'
12/11	3218
	Lans. 3180
12/18	Arb. 3409-14
	TD 5" @ 3410 RUST
12/24	T.D. 3421' 3300 acid.
12/31	T.D. 3424' 500 acid.
1942	
1/7	Arb. 3409'
	5" - 3410'
	T.D. 3424'
	3800 acid.
	Pump 82 oil plus 19% water.
	39. Gravity
	COMPLETED

Map No. 7-23 Sec. 26 Twp. 16 R. 13WWell No. 5 KultgenStanolind Company**FIRST REPORT**

Contractor

C NL NE NE

330 Ft. from N. Line Ft. from S. Line660 Ft. from E. Line Ft. from W. Line

SECTION PLAT

			o

TRAPP POOL

Location XXRig up Drilling and Remarks:

RECORD

Cased in., ft.Sand Gas Oil Total Depth

PRODUCTION

1st 24 hrs. Nat. 1st 24 hrs. after shot Gas Cu. Ft.Dry Hole Abandoned

Date

NOV 1 9 1941 19 S. I LEWIS Scout

Map No. 73 Sec. 26 Twp. 16 R. 13W

Well No. 5 Kultgen

Stanolind Company

COMPLETED Contractor

C N L N E N E

SECTION PLAT

330 Ft. from N. Line

_____ Ft. from S. Line

660 Ft. from E. Line

_____ Ft. from W. Line

			o

TRAPP POOL

RECORD

Location _____

Rig up _____

Drilling and Remarks:

Cased _____ in., _____ ft.

Sand _____

Gas _____

Oil _____

Total Depth 3424

PRODUCTION

1st 24 hrs. Nat. _____

1st 24 hrs. after shot _____

Gas _____ Cu. Ft.

Dry Hole _____

Abandoned _____

Cr 3409
5" C 3410
3800 cu ft
Pump 82 oil + 19% water.

390 Gr

Date

JAN 7 1942 19

S. I. LEWIS Scout