

DX 78-1


Sumner

KANSAS

Section 33 Township 34 Range 2E

Well No. #2 Chitwood

Company Salina Drlg.

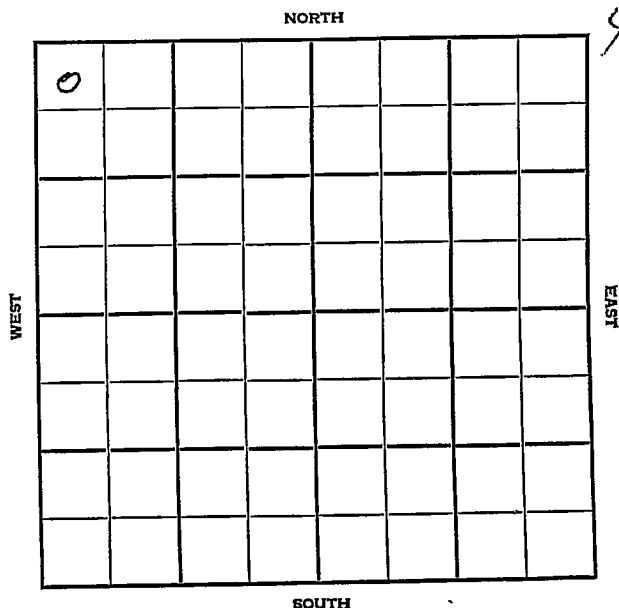

Sumner

KANSAS

SEC.	TWP.	R.
33	34	2E

WELL NO.

2 Chitwood

FARM

COMPANY

Salina Drlg.

CONTRACTOR

Capitt Drlg.


330' Ft. from N. Line

Ft. from S. Line

Ft. from E. Line

330' Ft. from W. Line

NW NW NW

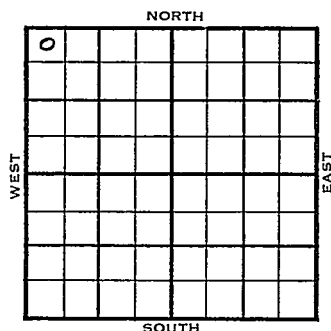

1955	ELEVATION	REPORT
	1194	

6/1 Spud 5-27-55
8" @ 135 w/100
Drlg 2000

8/31 Comm 5-27-55
H Stal 2394
Tr Layton 2835
KC 3026
BKC 3110
Cleve 3160
Oswego 3210
Bart 3444
Miss 3486
TD 3502
8" @ 135/100
5 1/2" @ 3500/75
DD 3506
FU 1660' oil 15 hr DD 3508 DD 3519
DD 3558 16 goph 12 gw 500 A frac
S/15 boph
Comp 25 bopd

COMPLETED

County Sumner State KansasSec. 33 (Blk. Twp.) 34 (Sur. Rge.) 2E Map No.Operator Salina Drlg.Well No. 2 Farm ChitwoodElev. Location NW NW NW

o						

330Ft. From N Line NW330Ft. From W Line Quarter1st. Report JUN 1 1955

Completion

Remarks

Capitt Drlg. - Contr.Spudding Date 5-27-55

Drlg. Data

8" @ 135 w/ 100 drlg. 2000

County Sumner Elev. 1194
 Sec. 33 Twp. 34 Rgs. 2E
 Company Salina Drlg.
 Farm Name Chitwood No. 2

TOPS	DEPTH	LOG	DATUM	Loc. in Sec.
Anh.				NW NW NW
TP.				
H. <u>Star</u>	<u>2394</u>		<u>1200</u>	
Tr. <u>Linton</u>	<u>2835</u>		<u>1041</u>	
Dg.				
BL.				
L.				
K.C.	<u>2026</u>		<u>1832</u>	Geol.
B.K.C.	<u>3110</u>		<u>1914</u>	Contr.
Ce. <u>Cleve</u>	<u>3160</u>		<u>1966</u>	
C. <u>Oswego</u>	<u>3210</u>		<u>2016</u>	Capitt
M. <u>Bart</u>	<u>2444</u>		<u>2270</u>	
M. <u>W</u>	<u>34816</u>		<u>2292</u>	Pool
K.				
Mz.				
Mq.				
V.				
S.				
S.				
A.				
R.				
PE.				
G.				
T.D.	<u>3502</u>			

COMPLETE

Date Comm. 5-27-55 AUG 31 1955

8" @ 135/100 5 1/2" @ 3500/75 DD 3506

FU 1660' oil 15 hr. DD 3508 DD 3519

DD 3558 16 goph. 12 gw. 500 A frac

S/ 15 boph Comp. 25 bopd