


Kansas

Map No. _____ Sec. 28 Twp. 29 R. 6Well No. 1 Walgest Farm _____Inland & Davis Company

NORTH

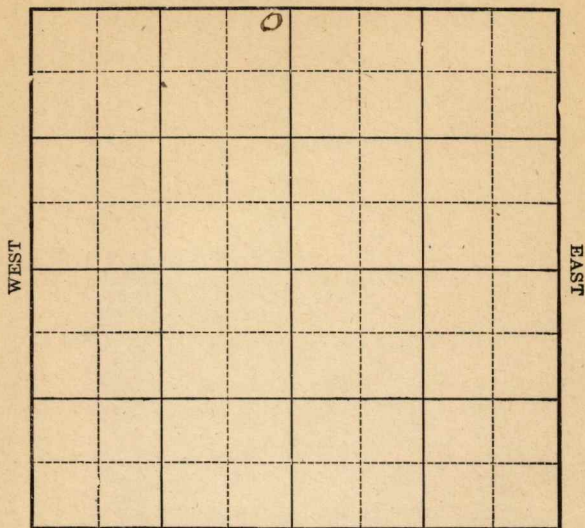

SOUTH

Location _____

Drilling Remarks:

Rig Up _____

Drilling Remarks:

RECORD

Cased _____ in. _____ ft.

Sand _____

Gas _____

Oil _____

Total Depth _____

PRODUCTION

1st 24 hrs. Nat. _____

1st 24 hrs. after shot _____

Gas _____ cu. ft.

Dry Hole _____

Abandoned _____

Map No. _____ Sec. 28 Twp. 29 R. 6


Well No. #1 Walz est Farm
Inland & Davis Company

200 Ft. from N, Line

_____ Ft. from S. Line

200 Ft. from E. Line

Ft. from W. Line

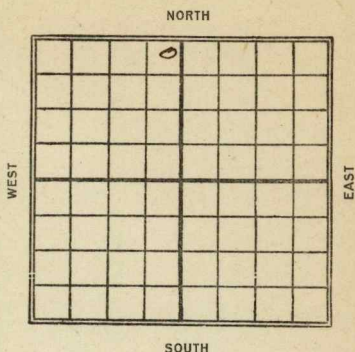

Date _____

REPORT

1922

3/20

Rig

3/30

De la paro.

5/21

28 Feb 3025'

1 Kansas

Map No. *K11* Sec. *28* Twp. *29* R. *6*

Well No. *1 Waly est.*

Tom Land & Davis Company

Contractor

FIRST REPORT

SECTION PLAT

200 Ft. from N. Line

_____ Ft. from S. Line

200 Ft. from E. Line

_____ Ft. from W. Line

	<i>6</i>		

Location _____

Rig up _____

Drilling and Remarks:

Rug

RECORD

Cased _____ in., _____ ft.

Sand _____

Gas _____

Oil _____

Total Depth _____

PRODUCTION

1st 24 hrs. Nat. _____

1st 24 hrs. after shot _____

Gas _____ Cu. Ft.

Dry Hole _____

Abandoned _____

Date

MAR 20 1922

_____ 191 _____

M. A. BENEAR

_____ Scout

Map No. 11 Kans. Sec. 28 Twp. 29 R. 6Well No. 1 Walz test.Island & Lewis Company

Contractor

ABANDONED**SECTION PLAT**200 Ft. from N. Line

----- Ft. from S. Line

200 Ft. from E. Line

----- Ft. from W. Line

Location -----

Rig up -----

Drilling and Remarks:

L & A3025'**RECORD**

Cased ----- in., ----- ft.

Sand -----

Gas -----

Oil -----

Total Depth -----

PRODUCTION

1st 24 hrs. Nat. -----

1st 24 hrs. after shot -----

Gas ----- Cu. Ft.

Dry Hole -----

Abandoned -----

Date

MAY 21 1922

191

M. A. BENJAN

Scout