


Section 26 Township 16 Range 13W

Well No. 5 Stueder

Company N C R A

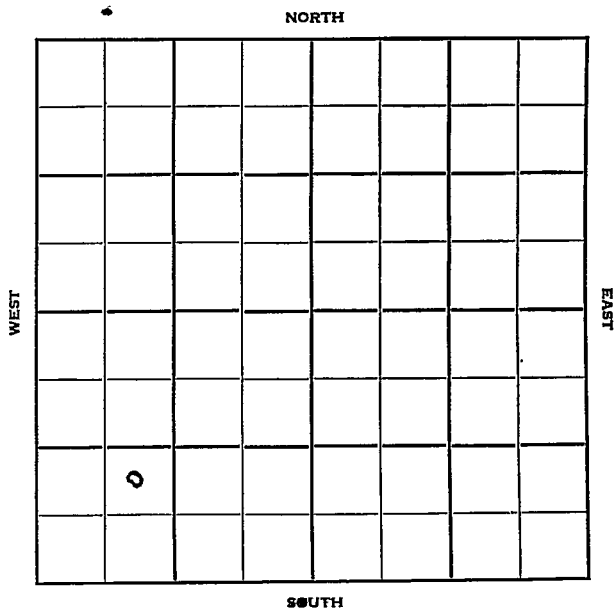

Sec. 26 Twp. 16 R. 13 W ✓

Well No. # 5 Stueder Farm _____

N C R A Company _____

Contractor _____


_____ Ft. from N. Line

990 Ft. from S. Line

_____ Ft. from E. Line

990 Ft. from W. Line

NE SW SW

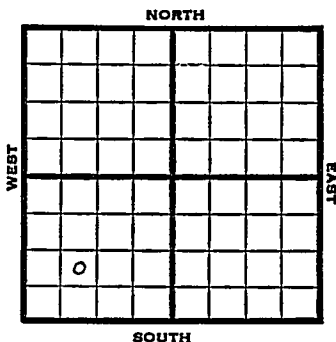

1951 Elev. 1920' REPORT

8/1 Spud 7-24-51
8" @ 256
Drlg. 2970'

8/22 Spud 7-24-51
Oil well TD 3380' 8" @ 256'
Heeb 3047' Dodge 3062' Lans. 3138'
TD 3378' 5" @ 3377' Arb. 3376'
DD 3380' S/2½ BOPH 8 hr.
500 A no inc.
Comp. 100 BOPD

COMPLETED

