

KANSAS


Saline

FORM 51 5M PETROL

Section 20 Township 16 Range 1-W

Well No. #2 J. W. Vanmeter


Company Deep Rock

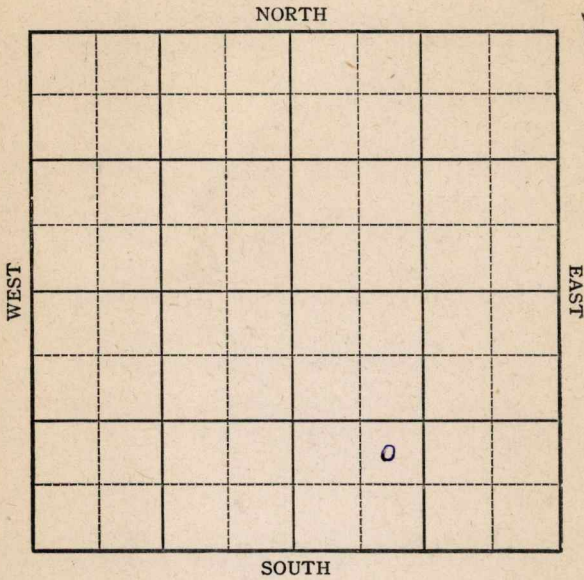

Sec. 20 Twp. 16 R. 1-W

Well No. #2 J. W. Vanmeter Farm
Deep Rock Company

NORTH

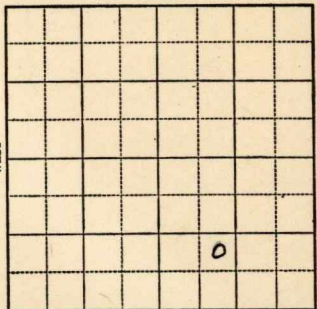

_____ Ft. from N. Line

990 Ft. from S. Line

_____ Ft. from E. Line

990 Ft. from W. Line

Elev. 1302

R E P O R T

1943

10/20 Location

10/27 Derrick

11/3 10" @ 130
Drig. 1720'

11/10 Miss 2618
T.D. 2828
Run Csg.

11/17 7" @ 2625'
TD 2631

SWb 20 oil per hr 10 hrs.

11/24 Temp Pot 99

12/1 " "

12/8 " "

12-15 " "

12/22 7" @ 2625

Miss 2618

Pump 189 Pot

TD 2631

Gravity 37

COMPLETED

