

Summer


KANSAS

SECTION 30 TOWNSHIP 34 RANGE 2 E

WELL NO. #1 Bauman

COMPANY Natural Gas & Oil

NORTH

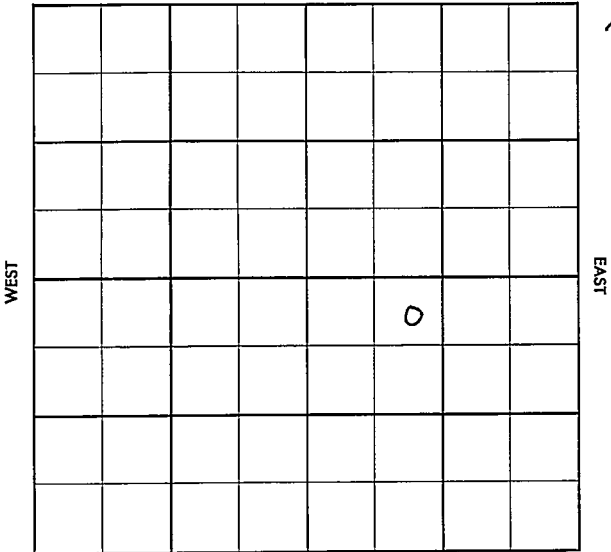

SOUTH

Summer

KANSAS

SEC.	TWP.	R.
30	34	2E

WELL NO. #1 Bauman FARM

COMPANY Natural Gas & Oil

CONTRACTOR White & Ellis


Wildcat

_____ Ft. from N. Line

_____ Ft. from S. Line

_____ Ft. from E. Line

_____ Ft. from W. Line

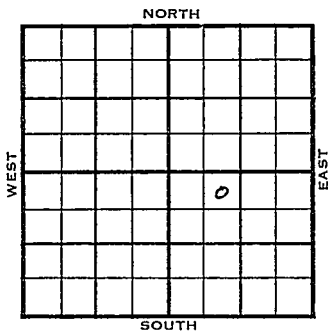

NE NW SE

1955	ELEVATION	REPORT
------	-----------	--------

11/2 Loc

County Sumner Elev. _____
 Sec. 30 Twp. 34 Rge. 2E
 Company Natural Gas & Oil
 Farm Name Bayman No. 1

TOPS	DEPTH	LOG	DATUM
Anh.			
TP.			
H.			
Tr.			
Dg.			
BL.			
L.			
K.C.			
B.K.C.			
Ce.			
C.			
M.			
M.			
K.			
Mz.			
Mo.			
V.			
S.			
S.			
A.			
R.			
PE.			
G.			
T.D.			

Loc. in Sec. NE NW SE

Geol. _____

Contr. White & Ellis

Pool _____

Wildcat

FIRST REPORT
NOV 2 1915

Date Comm. _____
 Location _____

Co.
 1915
 No.
 Sec.
 T.
 R.