

O.W.W.O.  
FORM 51  
6/30/44


O.W.D.D Summer

KANSAS

Section 33 Township 34 Range 2 E

Well No. # 1 Chandler ~~WEST~~

Company Bowman & Grismore

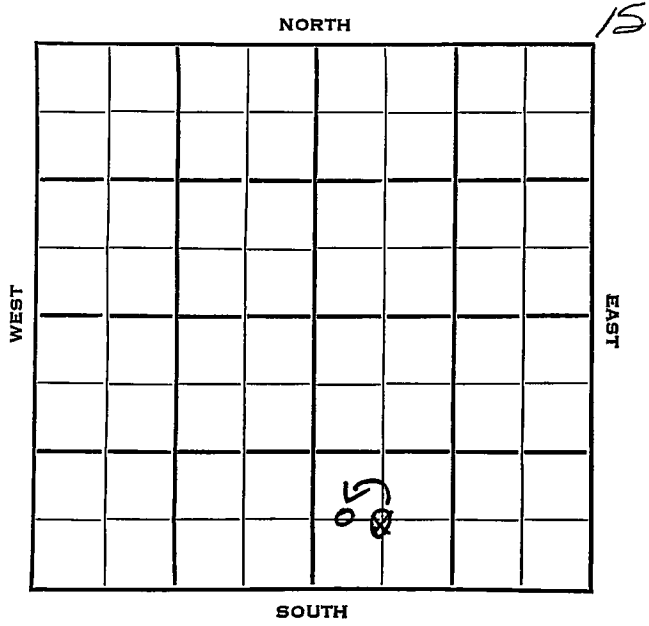

Sec. 33 Twp. 34 R. 2 E

Well No. # 1 Chandler ~~WEST~~ Farm

Bowman & Grismore Company

Eckland Drlg. Contractor


**Dyal Pool**

         Ft. from N. Line

660 Ft. from S. Line

         Ft. from E. Line

330  
~~660~~ Ft. from W. Line

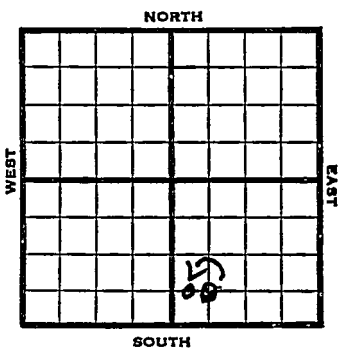

*C w/2*  
+ SW SE

1953 Elev. 1186' REPORT

6/24 Spud 6-20-53  
8" @ 125  
Drlg. 694

7/29 Spud 6-20-53  
D&A  
TD 3473  
8" @ 125  
Stal 2355, Layton 2790, KG 2991, Bart 3432, Miss 3455  
TD 3473  
D&A

**ABANDONED  
O.W.D.D**

1954

5/12 Stal. 2355', Layton 2790', KG 2991'  
Cleveland 3098', Bart 3432', Miss 3455'  
OTD 3473'  
5" @ 3205'  
40/ 3114-36 FU 150' fluid sd-frac testing.

6/23 ~~Spud~~  
Oil well  
TD 3473

**OVER**

1954

6/23 Stal 2355 Layton 2790 KC 2991  
Cleveland 3098 Bart 3432 Miss 3455  
OTD 3473  
5" @ 3205 40/ 3114-36 FU 150' fluid  
sd-frac Comp 50 bopd

**COMPLETED**

O.W.W.O.

1954

6/30

Oil well  
TD 3473'  
Stal. 2355', Layton 2790', KC 2991',  
Bart 3432', Miss 3455'  
OTD 3473'  
CO to 3160'  
5" @ 3160'  
Cleveland 3089'  
88/3114-36  
Sd-frac  
Comp. 50 bopd

**FIRST REPORT**

↓  
**COMPLETED**

County Sumner State Kansas

Sec. 33 (Blk. Twp.) 34 (Sur. Rge.) 2E Map No.

Operator Bowman & Crismore

Well No. 1 Farm Chandler

Elev. Location C SW SE


660 Ft. From S Line SE

660 Ft. From 17 Line Quarter

Ist. Report JUN 24 1953

Completion ..

Remarks

Eckland Drlg. - Contr.

Spudding Date 6-20-53

FIRST REPORT

Drlg. Data

8" @ 125 drlg. 694

County Sumner State Kansas

Sec. 33 (Blk. Twp.) 34 (Sur. Rge.) 2E Map No.

Operator Bowman & Grismore

Well No. 1 Farm Chandler

Elev. 1186 Location C SW SE


**ABANDONED**

660 Ft. From S Line SE

660 Ft. From W Line Quarter

Ist. Report

Completion JUL 29 1953

Remarks

Eckland Drlg. - Contr.

Spudding Date 6-20-53

Drlg. Data D & A TD 3473

8" @ 125 Stal. 2355 Layton 2790

KC 2991 Bart. 3432 Miss. 3455

TD 3473

D & A



**O. W. D. D**

County Summer State Kansas

Sec. 33 (Blk.) 34 (Sur.) 2E Map No.

Operator Bowman & Grissmore

Well No. 1 Farm Chandler West

Elev. Location C SW SE


660 Ft. From S Line SE

660 Ft. From W Line Quarter

1st. Report

Completion JUN 23 1954

Remarks OWDD

**O. W. D. D**

Spudding Date

Drlg. Data Oil well TD 3473

Stal. 2355 Layton 2790 KC 2991

Cleveland 3098 Bart. 3432 Miss. 3455

OTD 3473 5" @ 3205 40/ 3114-36

FU 150' fluid sd-frac Comp. 50 bopd

**J. G. McGEHEE**

