

Sec. 33 Twp. 34 R. 2 E

Well No. # 1 McGutchin Farm

Bowman & Grismore Company

Eckland Contractor

Ft. from N. Line

330


Ft. from S. Line

330

Ft. from E. Line

Ft. from W. Line

SE SE SW

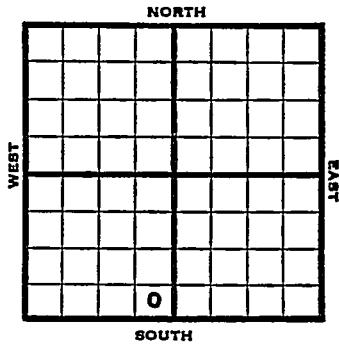

1953

Elev. 1176'

REPORT

6/10

Spud 6-6-53
8" @ 131
Drlg. 1530'

8/29

Spud 6-6-53
Oil Well
TD 3443
8" @ 131
Stal 2347, Layton 2797, KC 2987,
Oswego 3116, Bart 3416
TD 3443
4" @ 3443
CO to 3443
PB 3435, perf/3426-34,
Hydro
f/22 bopd
Comp. 20 bopd

COMPLETED

1954
3/10

O.W.W.O.

Bart 3416 OTD 3443' Cleve sd 3099
PB 3156 8/3114-16 8/3118-20
48/3126-38 8/3114-46 sd-oil-frac
F/40 BOPH F/28 BOPH

OVER

1954
3/31

Oil well TD 3443 Bart. 3416
OTD 3443 Cleveland sd 3099
PB 3156 8/3114-16 8/3118-20
48/3126-38 8/3144-46 sd-oil-frac.
F/40 BOPH F/28 BOPH
Comp. 25 BOPD

COMPLETED

