

KANSAS


Form 51-5M-7-39-Palace

Russell

Section 34 Township 14 Range 13-W

Well No. #2 Owens


Company R. H. Shields

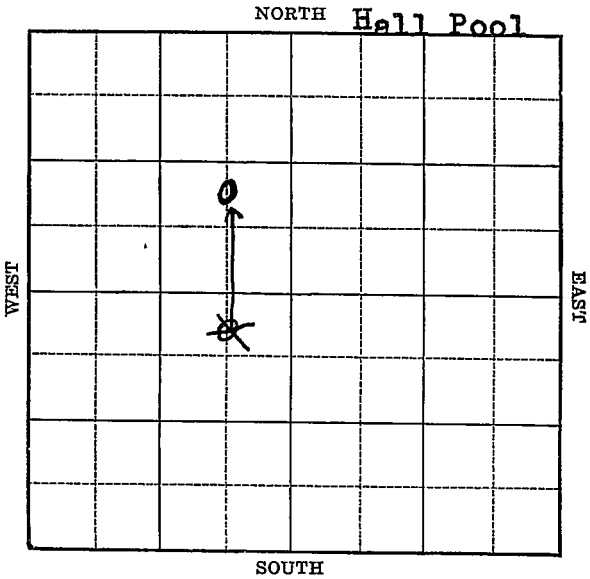

Sec. 34 Twp. 14 R. 13-WWell No. #2 Owens FarmR. H. Shields Company

(Hall)

NORTH

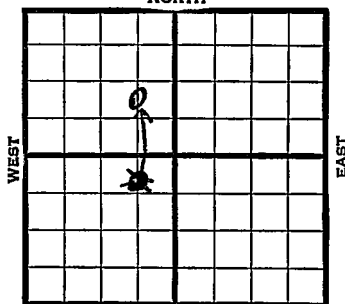

SOUTH

~~440~~ Ft. from N. Line999 Ft. from S. Line660 Ft. from E. Line

Ft. from W. Line

Elev. 1691

1940	REPORT
5/8	Cable rig.
5/16	" "
5/23	" "
5/29	Rigging up.
6/6	15½" - 621' 12½" - 318'
	Drlg. 320'
6/13	Anhy 610' 10" - 618'
	Drlg. 1565'
6/20	S.O. 2185-90' 8" - 2195'
	Drlg. 2362'
6/27	Topeka 2518' Lans. 2835'
	7" - 2838' Pay 2923-26'
	T.D. 2930'
7/3	" "
7/10	Lans. 2835'
	7" - 2835'
	T.D. 2930'
	5000acid.
	Potential 619 bbls., pump.
	COMPLETED

Map No. 72 Sec. 34 Twp. 14 R. 13WWell No. 2 OwensR. H. Shields

Company

Contractor

FIRST REPORT

C N L NE SW

440 Ft. from N. Line

_____ Ft. from S. Line

660 Ft. from E. Line

_____ Ft. from W. Line

HALL POOL

SECTION PLAT

	o		

Location _____

Rig up _____

Drilling and Remarks:

Cable Rig

RECORD

Cased _____ in., _____ ft.

Sand _____

Gas _____

Oil _____

Total Depth _____

PRODUCTION

1st 24 hrs. Nat. _____

1st 24 hrs. after shot _____

Gas _____ Cu. Ft.

Dry Hole _____

Abandoned _____

Date

MAY 8 1940 19

S. J. LEWIS Scout

Map No. _____ Sec. 34 Twp. 14 R. 13WWell No. 2 OwensR. H. Shields Company

Contractor

COMPLETED**SECTION PLAT**

C N L SE NW

_____ Ft. from N. Line

990 Ft. from S. Line660 Ft. from E. Line

_____ Ft. from W. Line

	?		

HALL POOL

Location _____

Rig up _____

Drilling and Remarks:

*Loss 2835**7" @ 2835.**5000 acid**Pump 619 P.X.***RECORD**

Cased _____ in., _____ ft.

Sand _____

Gas _____

Oil _____

Total Depth 2930**PRODUCTION**

1st 24 hrs. Nat. _____

1st 24 hrs. after shot _____

Gas _____ Cu. Ft.

Dry Hole _____

Abandoned _____

Date

JUL 10 1940 19

S. J. LEWIS Scout