


Barton KANSAS

Form 51-5M 5-37 Petrol

Section 27 Township 16 Range 13 ~~17~~

Well No. #1 Geo. Thorn #A#

Company Stanolind

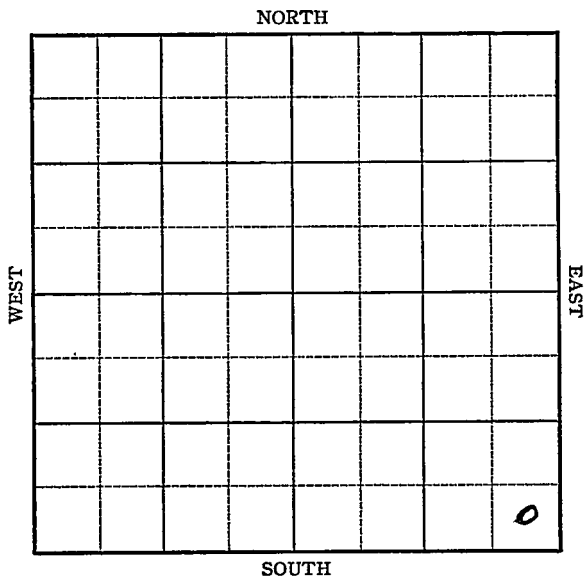

Sec. 27 Twp. 16 R. 13-W

Well No. #1 Geo. Thorn "A" Farm

Stamolin Company


         Ft. from N. Line

330 Ft. from S. Line

330 Ft. from E. Line

         Ft. from W. Line

Elev. 1901

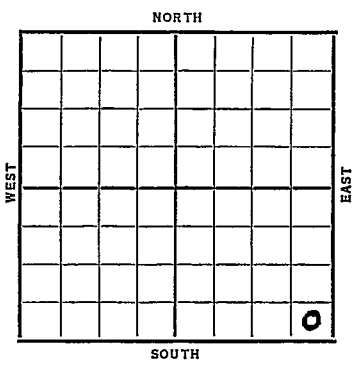

| Date  | REPORT   |
|-------|--|
| 1937  |  |
| 9/22  | B. R. R.   |
| 10/2  | R. R.  |
| 10/8  | 10" @ 240'. Drlg. 450'.                            |
| 10/15 | Drlg. 2960'.                                       |
| 10/22 | Sil. 3363-67' T.D. Sat. core.<br>6" @ 3364'. RUST. |
| 10/29 | " " "  |
| 11/5  | T.D. 3369'. 900 acid.                              |
| 11/12 | 2000 & 4000 acid. C.O.                             |
| 11/17 | 6" @ 3364'.  |
|       | Sil. 3363'.  |
|       | T.D. 3369'.  |
|       | 7800 acid.   |
|       | Potential 839 bbls.                                |
|       | COMPLETED  |
|       |  |
|       |  |
|       |  |
|       |  |

*Barton* KANSAS

Map No. \_\_\_\_\_ Sec. 27 Twp. 16 R. 1325

Well No. 1 Geo Thern "A"

Stanalind Company

Contractor \_\_\_\_\_

**FIRST REPORT**

\_\_\_\_\_ Ft. from N. Line

330 Ft. from S. Line

330 Ft. from E. Line

\_\_\_\_\_ Ft. from W. Line

**SECTION PLAT**

|  |  |  |   |
|--|--|--|---|
|  |  |  |   |
|  |  |  |   |
|  |  |  |   |
|  |  |  | 0 |

Location \_\_\_\_\_

Rig up \_\_\_\_\_

Drilling and Remarks:

*B.P.R.*

**RECORD**

Cased \_\_\_\_\_ in., \_\_\_\_\_ ft.

Sand \_\_\_\_\_

Gas \_\_\_\_\_

Oil \_\_\_\_\_

Total Depth \_\_\_\_\_

**PRODUCTION**

1st 24 hrs. Nat. \_\_\_\_\_

1st 24 hrs. after shot \_\_\_\_\_

Gas \_\_\_\_\_ Cu. Ft.

Dry Hole \_\_\_\_\_

Abandoned \_\_\_\_\_

Date

SEP 22 1937

19

H. D. Hatfield Scout

Map No. \_\_\_\_\_ Sec. 27 Twp. 16 R. 13WWell No. 1 Geo. Thorn "B"Stanolind Oil Company

Contractor \_\_\_\_\_

**COMPLETED**  
**SE/C**

\_\_\_\_\_ Ft. from N. Line

330 Ft. from S. Line330 Ft. from E. Line

\_\_\_\_\_ Ft. from W. Line

**SECTION PLAT**

|  |  |  |  |
|--|--|--|--|
|  |  |  |  |
|  |  |  |  |
|  |  |  |  |
|  |  |  |  |

Location \_\_\_\_\_

Rig up \_\_\_\_\_

Drilling and Remarks:

7800 acidPOT-839**RECORD**Cased 6 in., 3364 ft.~~Sand~~ 511 3363

Gas \_\_\_\_\_

Oil \_\_\_\_\_

Total Depth 3369**PRODUCTION**

1st 24 hrs. Nat. \_\_\_\_\_

1st 24 hrs. after shot \_\_\_\_\_

Gas \_\_\_\_\_ Cu. Ft.

Dry Hole \_\_\_\_\_

Abandoned \_\_\_\_\_

Date

NOV 17 1937 19H. D. Hatfield Scout