

KANSAS

Butler

Section 30 Township 29 Range 6-E


Well No. #2 Haver

Company Laura Jane Oil
Miscellaneous

NORTH

WEST

EAST

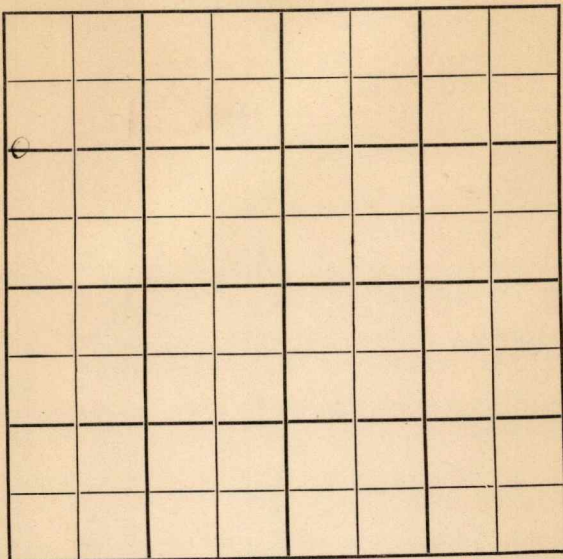

SOUTH

Butler
29

KANSAS

Sec. 30 Twp. R. 6E

Well No. #2 Haver Farm

Laura Jane Oil Company

Contractor

Miscellaneous


1320' Ft. from N. Line

Ft. from S. Line

Ft. from E. Line

30' Ft. from W. Line

C W L NW

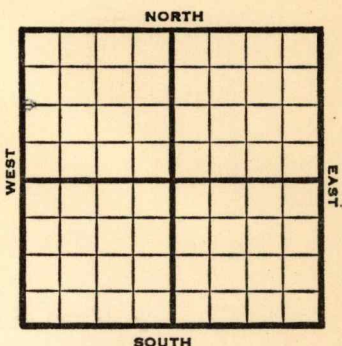

1950

Elev. 1329' REPORT

3/1

Bart. 2720'

TD 2744'

5" @ 2744'

Bart sd 2744-83

50 qts

Swab 2 wtr

1/4" oil PH

Est. 5 oil 25 wtr

Shut down

3/22

Bart 2720'

5" @ 2744'

TD 2744'

Comp 5 Oil

25 wtr.

Comp

COMPLETED

Kansas

Miscellaneous

Map No. _____ Sec. 30 Twp. 29 R. 6EWell No. 2 HaverLaura Jane Oil

Company _____

Contractor _____

C W L NW

El. 1329

SECTION PLAT

1320 Ft. from N. Line

_____ Ft. from S. Line

_____ Ft. from E. Line

30 Ft. from W. LineButler County

Location _____

Rig up _____

Drilling and Remarks:

Bart. 2720

TD 2744

5" @ 2744

Bart. sd. 2744-83

50 qts.

swab 2 water

 $\frac{1}{4}$ oil PHEst. 5 oil 25 waterDate Shut down

RECORD

Cased _____ in., _____ ft.

Sand _____

Gas _____

Oil _____

Total Depth _____

PRODUCTION

1st 24 hrs. Nat. _____

1st 24 hrs. after shot _____

Gas _____ Cu. Ft.

Dry Hole _____

Abandoned _____

MAR 1 1950

19

J. E. TYRA

Scout

Map No. _____ Sec. 30 Twp. 29 R. 6EWell No. 2 HaverLaura Jane Oil

Company

Contractor

C W L NW


E1. 1329

SECTION PLAT

1320 Ft. from N. Line

_____ Ft. from S. Line

_____ Ft. from E. Line

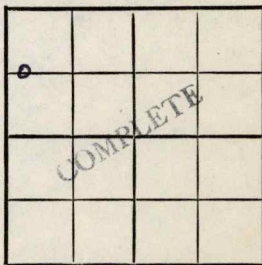30 Ft. from W. Line

Butler County

Location _____

Rig up _____

Drilling and Remarks:

Rate. 27205" C 2744T.D. 2744Comp 5 oil
25 water

RECORD

Cased _____ in., _____ ft.

Sand _____

Gas _____

Oil _____

Total Depth _____

PRODUCTION

1st 24 hrs. Nat. _____

1st 24 hrs. after shot _____

Gas _____ Cu. Ft.

Dry Hole _____

Abandoned _____

Date

MAR 22 1950 19J. E. TYRA Scout