


Barton

KANSAS

Section.....27.....Township.....16.....Range.....13-W

Well Number.....1 - Morrison "A".....

Company.....Stanolind.....

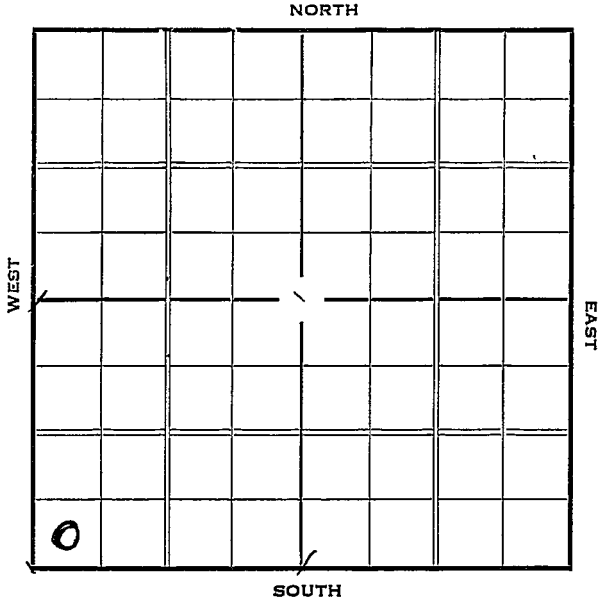


KANSAS

Barton

Sec. 27 Twp. 16 R. 13-WWell No. #1 Morrison "A" FarmStanolind Company Ft. from N. Line330 Ft. from S. Line Ft. from E. Line330 Ft. from W. Line


Elev. 1942

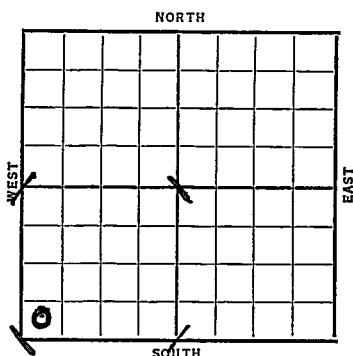

Date	REPORT
1937	
9/8	Location
9/17	Cellar.
9/24	10" @ 240'. WOC.
10/2	Dr lg. 2270'.
10/8	Dr lg. 3180'.
10/15	K.C. 3180'. Sil. 3410'.
	6" @ 3417'. T.D. 3425' S.O.
	RUST.
10/20	10" @ 240'.
	6" @ 3417'.
	Sil. 3410'.
	T.D. 3425'.
	Small S.O. & H.F.W.
	ABANDONED

Map No. _____ Sec. 27 Twp. 16 R. 13WWell No. 1-Morrison 'A'Stanolind Company

Contractor _____

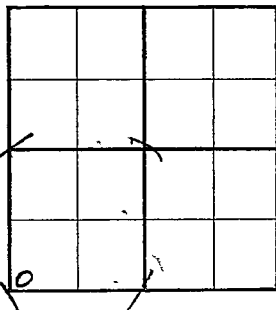FIRST REPORT**SECTION PLAT**

_____ Ft. from N. Line

330 Ft. from S. Line

_____ Ft. from E. Line

330 Ft. from W. LineLocation ✓

Rig up _____

Drilling and Remarks:

RECORD

Cased _____ in., _____ ft.

Sand _____

Gas _____

Oil _____

Total Depth _____

PRODUCTION

1st 24 hrs. Nat. _____

1st 24 hrs. after shot _____

Gas _____ Cu. Ft.

Dry Hole _____

Abandoned _____

Date

SEP 8 1937 19

H. D. Hatfield

Scout

KANSAS

Barton

Map No. _____ Sec. 27 Twp. 16 R. 13WWell No. 1 Morrison "A"Stanolind Company

Contractor

ABANDONED

SW/C

SECTION PLAT

0			

_____ Ft. from N. Line

330 Ft. from S. Line

_____ Ft. from E. Line

330 Ft. from W. Line

Location _____

Rig up _____

Drilling and Remarks:

*Small S.O. & H.F.W**DYA**10 - 240*
RECORDCased 6 in., 3417 ft.Sand 511 3410

Gas _____

Oil _____

Total Depth 3425

PRODUCTION

1st 24 hrs. Nat. _____

1st 24 hrs. after shot _____

Gas _____ Cu. Ft.

Dry Hole _____

Abandoned _____

Date

OCT 20 1937

19

H. D. Hatfield Scout