


Section 30 Township 29 Range 6E

Well No. 1 Owens

Company Bedell & Catt

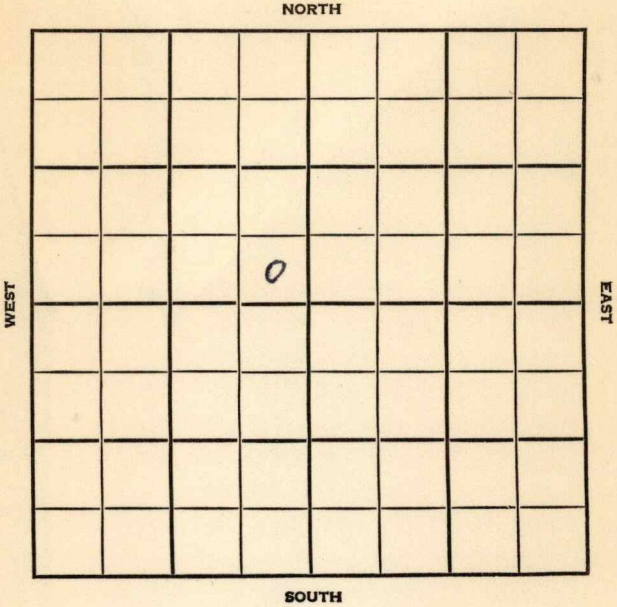

Butler KANSAS


SEC.	TWP.	R.
30	29	6E

WELL NO. 1 Owens FARM

COMPANY Bedell & Catt

CONTRACTOR Co. Tools

_____ Ft. from N. Line
 330 _____ Ft. from S. Line
 330 _____ Ft. from E. Line
 _____ Ft. from W. Line

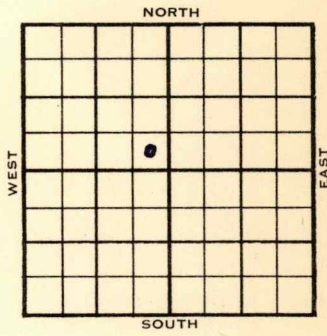

SE SE NW

1954	ELEVATION	REPORT
------	-----------	--------

9/15 Drlg. 2000'
 9/22 Spud 9-10-54
 KC 2093', Miss 2774'
 TD 2783'
 D&A
ABANDONED

