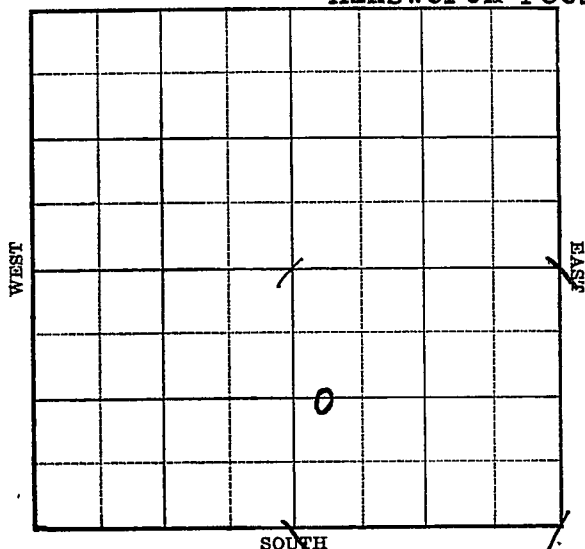


Section 27 Township 16 Range 13-WWell No. #3 Geo. Thorne "A"Company StanolindNORTH Ainsworth Pool

Map No. _____ Sec. 27 Twp. 16 R. 13WWell No. 3 Geo. Thorne "A"

Stanolind _____ Company

Contractor _____

FIRST REPORT

C $W\frac{1}{2}$ $W\frac{1}{2}$ SE


_____ Ft. from N. Line

1320 Ft. from S. Line

_____ Ft. from E. Line

330 Ft. from W. Line

SECTION PLAT

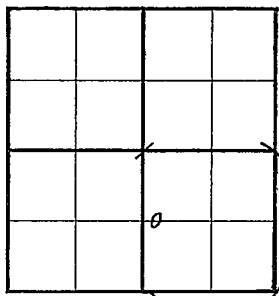

AINSWORTH POOL

Location _____

Rig up _____

Drilling and Remarks: ROTARY

RECORD

Cased _____ in., _____ ft.

Sand _____

Gas _____

Oil _____

Total Depth _____

PRODUCTION

1st 24 hrs. Nat. _____

1st 24 hrs. after shot _____

Gas _____ Cu. Ft.

Dry Hole _____

Abandoned _____

Date

JUN 21 1939

19

S. J. LEWIS

Scout

Barton KANSAS

Map No. 73 Sec. 27 Twp. 16 R. 13WWell No. 3 Geo. Thorne "A"Stanolind

Company


Contractor

COMPLETED

C $W\frac{1}{2}$ $W\frac{1}{2}$ SE Ft. from N. Line1320 Ft. from S. Line Ft. from E. Line330 Ft. from W. Line

AINSWORTH POOL

SECTION PLAT

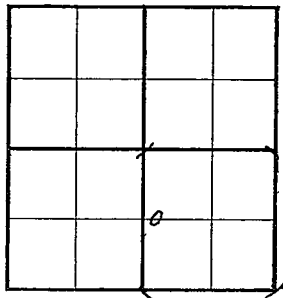Location Rig up

Drilling and Remarks:

*Per 83395**5" @ 3395**500 acid**Minimum**15 ft*

RECORD

Cased in., ft.Sand Gas Oil Total Depth 2409

PRODUCTION

1st 24 hrs. Nat. 1st 24 hrs. after shot Gas Cu. Ft.Dry Hole Abandoned

Date

JUL 10 1939 19S. J. LEWIS

Scout