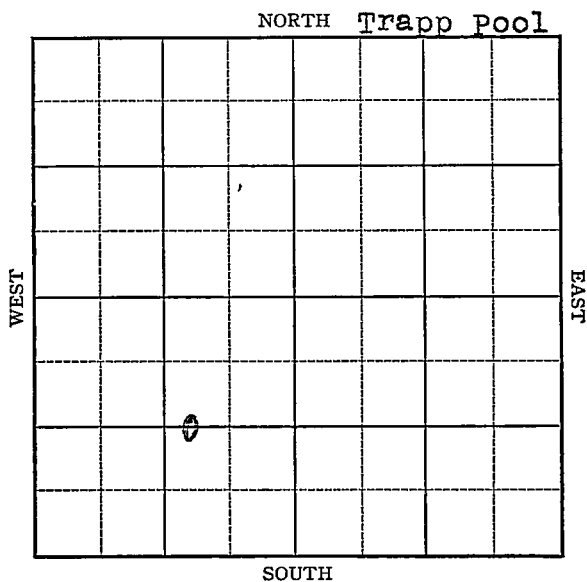


Barton **KANSAS**Section 27 Township 16 Range 13-WWell No. 5 Morrison "A"Company Stanolind

KANSAS

Barton

Sec. 27 Twp. 16 R. 13-WWell No. #5 Morrison "A" FarmStanolind Company


(Trapp)

1320 Ft. from N. Line Ft. from S. Line990 Ft. from E. Line Ft. from W. Line

Elev. 1948

O.W.W.O.

REPORT

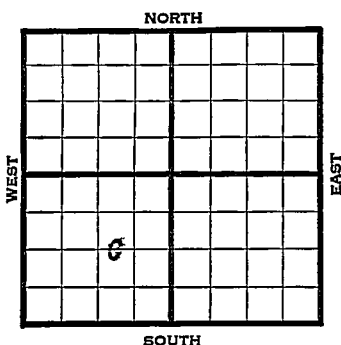

1941	REPORT
10/1	Location
10/9	8" - 251' WOC.
10/16	Anhy 860' Drlg. 2600'
10/23	Lans. 3175' Drlg. 3410' S.O.
10/30	Arb. 3412-15' T.D. 5" - 3412'
	RUST.
11/5	Arb. 3412' L
	5" - 3412'
	T.D. 3415'
	Echometer potential 3418 bbls.
	Maximum 3000 bbls.
	39. Gravity
	COMPLETED
1950	O.W.W.O.
7/26	Lans 3176 Arb 3410-13
	5" @ 3412
	Arb prod

	BB 3340
	32/3296-3304, 3000 acid
	OVER

1950 (information brought forward)

7/26 40/3238-48

4000 acid

Pump 105 bopd

Settled to 88 bopd

Completed

FIRST REPORT

COMPLETED

Barton

KANSAS

Map No. K-73 Sec. 27 Twp. 16 R. 13WWell No. 5 Morrison "A"Stanolind Company

Contractor

FIRST REPORTC WL E $\frac{1}{2}$ SW**SECTION PLAT**

1320 Ft. from N. Line Ft. from S. Line990 Ft. from E. Line Ft. from W. Line

TRAPP POOL

RECORDLocation Cased in., ft.Rig up Sand Drilling and Remarks: Gas Oil Total Depth **PRODUCTION**1st 24 hrs. Nat. 1st 24 hrs. after shot Gas Cu. Ft.Dry Hole Abandoned

Date

OCT 1 1941 19S. J. LEWIS Scout

Map No. K-73 Sec. 27 Twp. 16 R. 13WWell No. 5 Morrison "A"Stanolind CompanyCOMPLETED ContractorC WL E $\frac{1}{2}$ SW1320 Ft. from N. Line Ft. from S. Line990 Ft. from E. Line Ft. from W. Line

SECTION PLAT

TRAPP POOL

RECORD

Location Rig up

Drilling and Remarks:

*Cor 8412**5" @ 3412**Echo R 8415**May 2000**39 2/3*Cased in., ft.Sand Gas Oil Total Depth 8415

PRODUCTION

1st 24 hrs. Nat. 1st 24 hrs. after shot Gas Cu. Ft.Dry Hole Abandoned

Date

NOV 5 1941 19 S. J. LEWIS Scout

Map No. _____ Sec. 27 Twp. 16 R. 13WWell No. 5 Morrison "A"

Stanolind

Company

Contractor

C $W\frac{1}{2}$ E $\frac{1}{2}$ SWEl. 1948
SECTION PLAT1320 Ft. from N. Line

_____ Ft. from S. Line

990 Ft. from E. Line

_____ Ft. from W. Line



Barton County

Location _____

Rig up _____

Drilling and Remarks:

Lans. 3175

Arb. 3410-13

5" @ 3412

Arb. prod.

PB 3340

32/ 3296-3304

3000 acid

Date

RECORD

Cased _____ in., _____ ft.

Sand _____

Gas _____

Oil _____

Total Depth _____

PRODUCTION

1st 24 hrs. Nat. _____

1st 24 hrs. after shot _____

Gas _____ Cu. Ft.

Dry Hole _____

Abandoned _____

JUL 26 1950 19

J. E. TYRA Scout

40/ 3238-48

4000 acid

Pump 105 bopd

Settled to 88 bopd

Comp.

Scout Cards

Land Small Map

Land Wall Map

Tracings

France Map

Pierce Map

Misc.

JUL 31 1950