


Section 27 Township 16 Range 13-W

Well No. 3 Morrison "A"


Company Stanolind

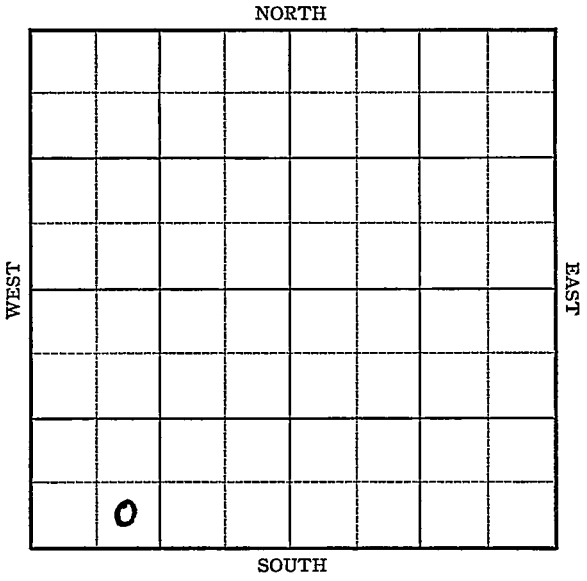

Sec. 27 Twp. 16 R. 13-W

Well No. #3 Morrison "A" Farm
Stanolind Company

_____ Ft. from N. Line
330 Ft. from S. Line
 _____ Ft. from E. Line
990 Ft. from W. Line

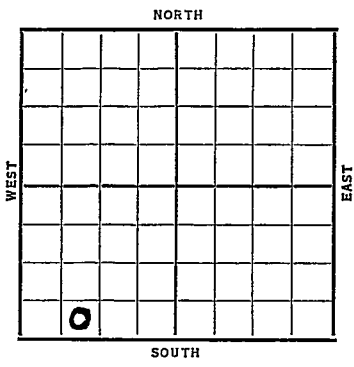

Elev. 1958

Date	REPORT
1937	
10/6	R. R.
10/15	"
10/22	"
10/29	Rig.
11/5	"
11/12	10" @ 325'. Anhy 885'. Drlg. 1510'.
11/19	Drlg. 2930'.
11/26	Sil. 3413'. Sat. 3413-3416'. T.D. 3417'. Rng. 7".
12/3	7" @ 3413'. RUST.
12/10	" " "
12/17	T.D. 3419'. Swab 10 bbls. oil per hour. 2000 acid. Swab 35 bbls. oil per hour.
	OVER

1937

12/22 7" @ 3413'.

Sil. 3413'.

T.D. 3419'.

2000 acid.

Potential 1985 bbls .

COMPLETED

Map No. _____ Sec. 27 Twp. 16 R. 13WWell No. 3 Morrison "A"Stanolind

Company

Contractor

SE SW SW

FIRST REPORT

SECTION PLAT

_____ Ft. from N. Line

330 Ft. from S. Line

_____ Ft. from E. Line

990 Ft. from W. Line

Location _____

Rig up _____

Drilling and Remarks:

RR

RECORD

Cased _____ in., _____ ft.

Sand _____

Gas _____

Oil _____

Total Depth _____

PRODUCTION

1st 24 hrs. Nat. _____

1st 24 hrs. after shot _____

Gas _____ Cu. Ft.

Dry Hole _____

Abandoned _____

Date

OCT - 6 1937

19

H. D. Hatfield

Scout

Barton **KANSAS**

Map No. 73 Sec. 27 Twp. 16 R. 13W

Well No. 3 Morrison "A"

Stanolind Company

Contractor

COMPLETED

SECTION PLAT

SE SW SW
Ft. from N. Line

330 Ft. from S. Line

Ft. from E. Line

990 Ft. from W. Line

0			

Location _____

Rig up _____

Drilling and Remarks:

2000 acid

POT-1985

RECORD

Cased 7 in., 3413 ft.

Sand 511 3413

Gas _____

Oil _____

Total Depth 3419

PRODUCTION

1st 24 hrs. Nat. _____

1st 24 hrs. after shot _____

Gas _____ Cu. Ft.

Dry Hole _____

Abandoned _____

Date

DEC 22 1987 19

H. D. Hatfield Scout