

Barton

KANSAS

Section 27 Township 16 Range 13 W

Well No. #5 Wilborn

Company N C R A

NORTH

					0		

WEST

EAST

SOUTH

Barton

KANSAS ✓

Sec. 27 Twp. 16 R. 13W

Well No. #5 Wilborn Farm

N C R A Company

Anschutz Drlg. - Contr. Contractor

Trapp Pool


990' Ft. from N. Line

_____ Ft. from S. Line

_____ Ft. from E. Line

990' Ft. from W. Line

SE NW NE

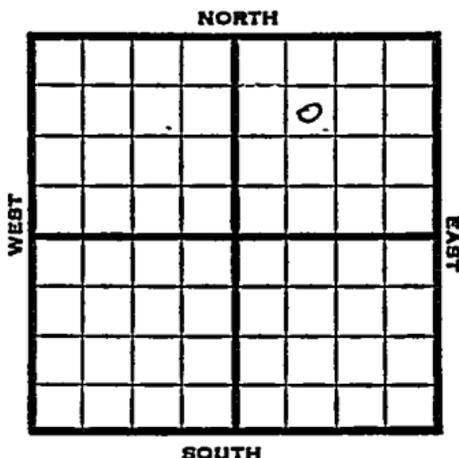

1951

Elev. 1929' REPORT

1/31

Spud 1-24-51
8" @ 284'
Anhy 850
Drlg. 2440'

2/14

Spud 1-24-51
D&A TD 3416
8" @ 284' Anhy 850'
Top 2825' Heeb. 3059'
Br Line 3142' Lans. 3151'
Cong. 3392' Arb. 3406-08
5" @ 3407'
TD 3409'
S/20 gw 15 hr. DD 3416
FU 2116' wtr D&A

ABANDONED

