

Barton

DX 78-1


KANSAS

Section 28 Township 16 Range 13W

Well No. #1 Heflin

Company Francis Hawn

NORTH

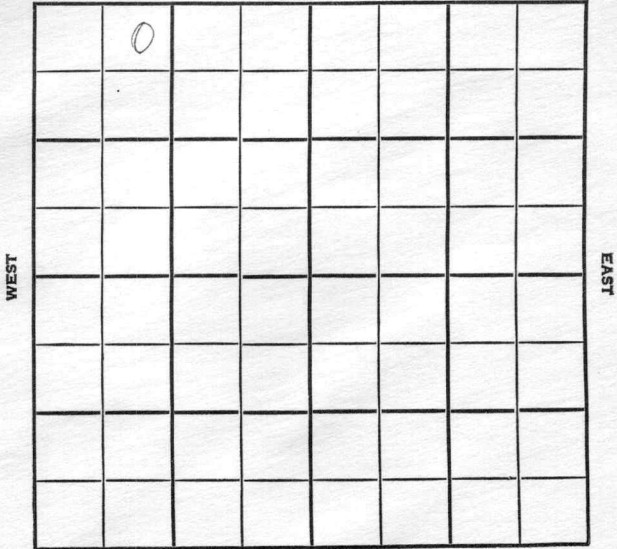

SOUTH

Co.

Use

No.

Sec.

T.

R.

County Barton Elev. 1954
 Sec. 28 Twp. 16 Rge. 13W
 Company Francis Hawn
 Farm Name Heflin No. 1

TOPS	DEPTH	LOG	DATUM
Anh.	900		
TP.			
H.	3080		
Tr.			
Dg.			
Bl.	3161		
L.	3169		
M.C.			
B.K.C.	3358		
Ce.			
C.			
M.			
M.			
K.			
Mz.			
Mo.			
V.			
S.			
S.			
A	3409		
R.			
PE.			
G.			
T.D.	3415		

Loc. in Sec. NE NW NW
 Geol. _____
 Contr. _____
S. & W. Tools
 Pool _____
Trapp

COMPLETE
 DEC 13 '56

Date Comm. _____
 Location NOV 7 '56 WOR NOV 13 '56
11-9-56 8 7/8 315/200
1765 NOV 21 '56 DST 3169-86 1 hr
30' Md BHP 525/20 DST 3299
-3332 1 hr 10' Md BHP 0/20"
DST 3394-3415 1 hr. net 360' wtu
+ 900' G & MCO & W 860/20" 4 1/2
@ 3410/75 NOV 28 '56 17 IN. DEC 5 '56 CO
3415 DEC 12 '56 8 1/2 Boph + 5 Bwph
17 & W