


Section 28 Township 16 Range 13W

Well No. #1 Redetzke

Company John Lindas Oil

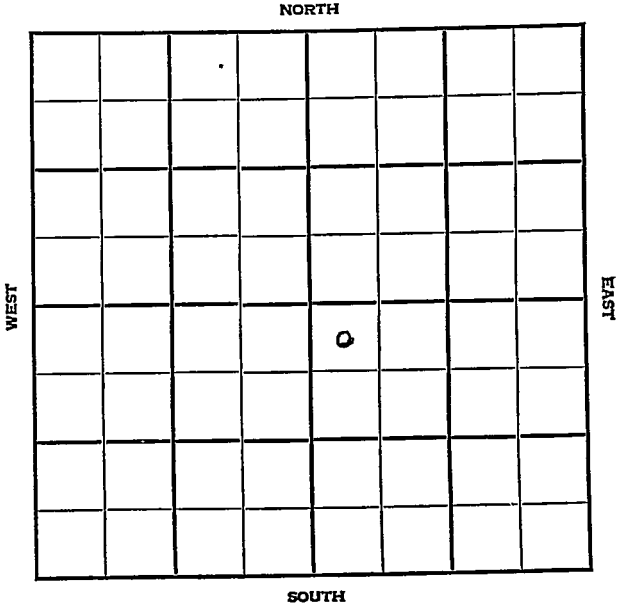

Sec. 28 Twp. _____ R. 16 13W

Well No. #1 Redetzke Farm _____
John Lindas Oil Company _____

Kraft-Prusa


330' Ft. from N. Line

_____ Ft. from S. Line

_____ Ft. from E. Line

330' Ft. from W. Line

NW SE

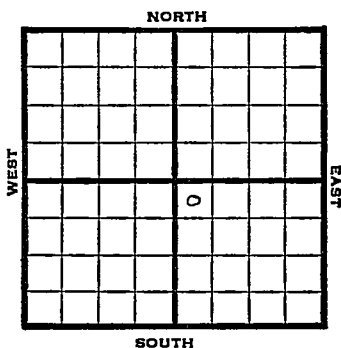

1948 EL 1977' REPORT

5/26 8" @ 221'
 Drlg. 2885'

6/1 Drlg. 3015'
 6/9 Lansing 3206'
 Arbuckle 3430'
 TD 3431
 5"@ 3430'
 RUST

6/16 2200' oil
 6/23 TD 3434'
 Arb. 3430'
 5"@ 3430'
 Depth Pot 1493 Oil
 42⁶ Gr.
 Comp.

COMPLETED

Map No. _____ Sec. 28 Twp. 16 R. 13W

Well No. 1 Redet₇ke

John Lindas Oil Company

FIRST REPORT Contractor

NW SE

SECTION PLAT

330 Ft. from N. Line

_____ Ft. from S. Line

_____ Ft. from E. Line

330 Ft. from W. Line

		o	

Barton County

Location _____

Rig up _____

Drilling and Remarks:

8" @ 221

drlg. 2885

RECORD

Cased _____ in., _____ ft.

Sand _____

Gas _____

Oil _____

Total Depth _____

PRODUCTION

1st 24 hrs. Nat. _____

1st 24 hrs. after shot _____

Gas _____ Cu. Ft.

Dry Hole _____

Abandoned _____

Date

MAY 26 1948 19

S. J. LEWIS Scout

Map No. 73 Sec. 28 Twp. 16 R. 13W

Well No. 1 Redetzke

John Lindas Oil Company

COMPLETE

Contractor

NW SE

E 11977

SECTION PLAT

330 Ft. from N. Line

 Ft. from S. Line

 Ft. from E. Line

330 Ft. from W. Line

		6	

Barton County

Location

Rig up

Drilling and Remarks:

Cor 83430
5' @ 3430
Depth 3430
1493 acb
H. E. G.

RECORD

Cased in., ft.

Sand

Gas

Oil ✓

Total Depth 3434

PRODUCTION

1st 24 hrs. Nat.

1st 24 hrs. after shot

Gas Cu. Ft.

Dry Hole

Abandoned

Date

JUN 23 1948 19

S. J. LEWIS

Scout