


Section 28 Township 16- Range 13-W
 Well No. #2 Redetzke
 Company Jphn Lindas etal

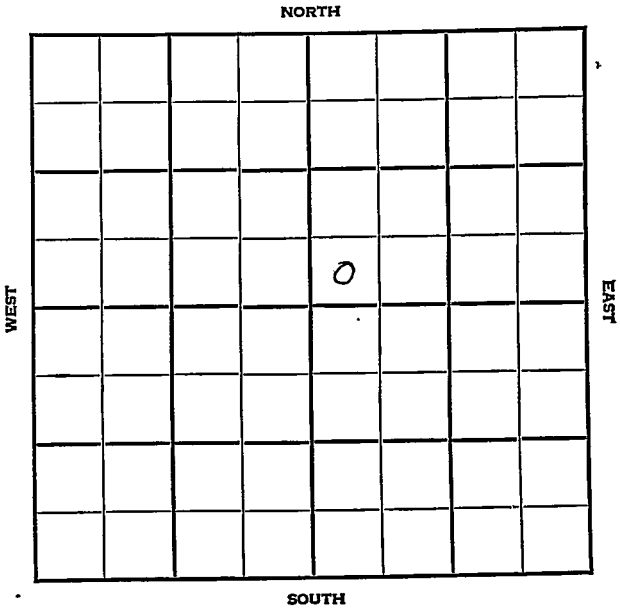


Sec. 28 Twp. 16 R. 13WWell No. #2 Redetzke FarmJohn Lindas et al Company

Trapp Pool

 Ft. from N. Line330' Ft. from S. Line Ft. from E. Line330' Ft. from W. Line

SW NE

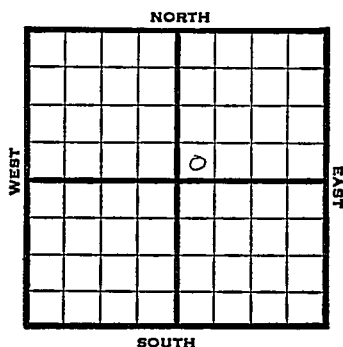

1948

Eli 1975' REPORT

6/23 8" @ 220'
Anhy. 918'
Drlg. 1806'

6/29 Arbuckle 3430'
TD 3431'
5" @ 3430'
RUST

7/8 2600' oil 2 hrs.
7/14 " "
7/21 " "
7/28 Arb. 3430'
5" @ 3430'
TD 3431'
Depth Pot 3000 Oil
40⁹ Gr.
Comp.

COMPLETED

Map No. _____ Sec. 28 Twp. 16 R. 13W

Well No. 2 Redet,ke

John Lindas etal.

Company

FIRST REPORT

Contractor

SW NE

SECTION PLAT

_____ Ft. from N. Line

330 Ft. from S. Line

_____ Ft. from E. Line

330 Ft. from W. Line

Barton County

RECORD

Location _____

Cased _____ in., _____ ft.

Rig up _____

Sand _____

Drilling and Remarks:

Gas _____

Oil _____

Total Depth _____

8" @ 220

Anhy 918

drlg. 1806

PRODUCTION

1st 24 hrs. Nat. _____

1st 24 hrs. after shot _____

Gas _____ Cu. Ft.

Dry Hole _____

Abandoned _____

Date

JUN 23 1948 19

S. J. LEWIS

Scout

Barton County Kansas State

Map No. 73 Sec. 28 Twp. 16 R. 13W

Well No. 2 Redetzke

John Lindas et al. Company

COMPLETE

Contractor

SW NE


E. 1925
SECTION PLAT

 Ft. from N. Line

330 Ft. from S. Line

 Ft. from E. Line

330 Ft. from W. Line

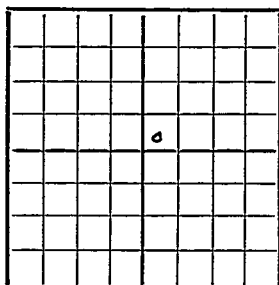

Trapp Pool

Remarks:

Per 83430

5" 83430

83431

Dep't to Pa 8000 net

40 1/2 in

Date
JUL 28 1948

Scout
S. J. LEWIS