

KANSAS

FORM 51 SM 10-41 PETROL


Barton

Section 28 Township 16 Range 13-W

Well No. #2 Stoskoppf

Company Continental

(Trapp)

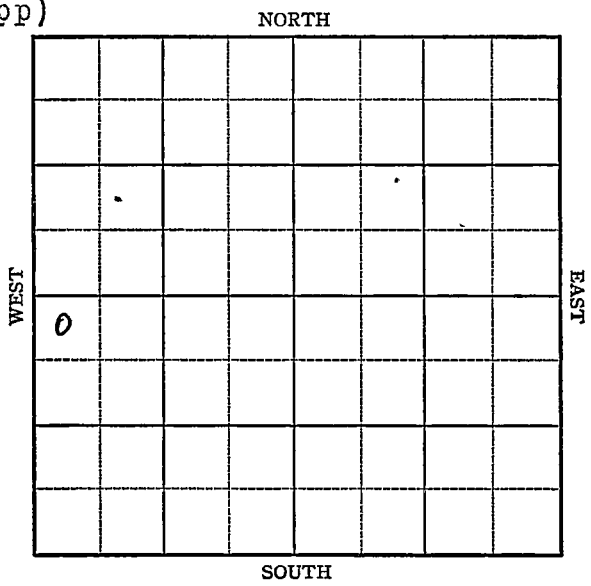

Sec. 28 Twp. 16 R. 13-71

Well No. #2 Stoskopf Farm

Continental Company


(Trapp)

330 Ft. from N. Line

_____ Ft. from S. Line

_____ Ft. from E. Line

330 Ft. from W. Line

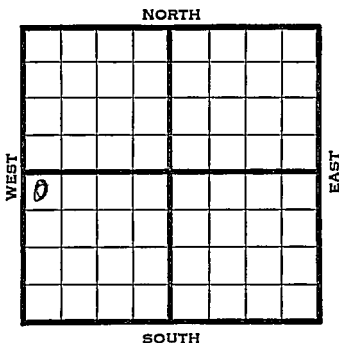

Elw. 1934

1941	REPORT
12/10	Rigging up. Rotary
12/18	10" @ 409 Drlg. 2170
12/24	Drlg. 2975'
12/31	Lans. 3116' Quartzite 3358-70' TD 3370' 6" - 3368' RUST.
1942	
1/8	Ripped 3153-63' 500 acid. 1800' oil.
1/14	Lans. 3116' 6" - 3368' T.D. 3370' Ripped casing 3153-63' 500 acid. Pump 41.7 oil & 9 water. 35.7 Gravity
	COMPLETED

Barton

KANSAS

Map No. 23 Sec. 28 Twp. 16 R. 13W

Well No. 2 Stoskopf

Continental Company

FIRST REPORT Contractor

NW SW

SECTION PLAT

330 Ft. from N. Line

0	1		

_____ Ft. from S. Line

_____ Ft. from E. Line

330 Ft. from W. Line

TRAPP POOL

RECORD

Location _____

Cased _____ in., _____ ft.

Rig up _____

Sand _____

Drilling and Remarks:

Gas _____

Rigging up

Oil _____

Rotary

Total Depth _____

PRODUCTION



1st 24 hrs. Nat. _____

1st 24 hrs. after shot _____

Gas _____ Cu. Ft.

Dry Hole _____

Abandoned _____

Date

DEC 1 0 1941 19

S. J. LEWIS Scout

Barton **KANSAS**Map No. 73 Sec. 28 Twp. 16 R. 13WWell No. 2 StoskopfContinental CompanyCOMPLETED Contractor

SECTION PLAT

NW SW

330 Ft. from N. Line

_____ Ft. from S. Line

_____ Ft. from E. Line

330 Ft. from W. Line

0			

TRAPP POOL

Location _____

Rig up _____

Drilling and Remarks:

*Lane 3116**6" @ 3368**Refract Log 3153-63**500 Oil**Pump 417 oil + 9 Water**352 gal*

RECORD

Cased _____ in., _____ ft.

Sand _____

Gas _____

Oil _____

Total Depth 3270

PRODUCTION

1st 24 hrs. Nat. _____

1st 24 hrs. after shot _____

Gas _____ Cu. Ft.

Dry Hole _____

Abandoned _____

Date

JAN 14 1942 19S. J. LEWIS Scout