

KANSAS


Barton

FORM 51 5M 4-41 PETROL

Section 29 Township 16 Range 13-W

Well No. #1 Harrington

Company Continental
(Trapp)

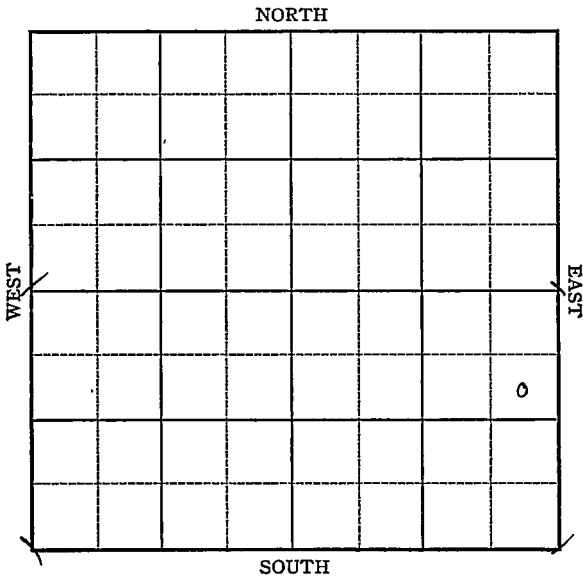

1941

10/8

Lans. 3130'

6" - 3400'

T.D. 3402'

Ripped casing 3140-45'

" " 3145-50'

" " 3140-50'

5500 acid.

Potential 366 bbls., pump.

39. Gravity

COMPLETED

KANSASMap No. _____ Sec. 29 Twp. 16 R. 13WWell No. 1 HarringtonContinental

_____ Company

_____ Contractor

FIRST REPORT

SE NE SE

990 Ft. from N. Line


_____ Ft. from S. Line

330 Ft. from E. Line

_____ Ft. from W. Line

TRAPP POOL

SECTION PLAT

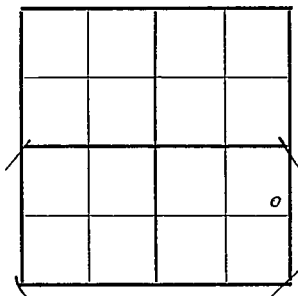

Location _____

Rig up _____

Drilling and Remarks:

Derrick

RECORD

Cased _____ in., _____ ft.

Sand _____

Gas _____

Oil _____

Total Depth _____

PRODUCTION

1st 24 hrs. Nat. _____

1st 24 hrs. after shot _____

Gas _____ Cu. Ft.

Dry Hole _____

Abandoned _____

Date

JUL 30 1941 19S. I. LEWIS Scout

Map No. K-23 Sec. 29 Twp. 16 R. 13W

Well No. 1 Harrington

Continental Company

COMPLETED Contractor

SE NE SE

SECTION PLAT

990 Ft. from N. Line

_____ Ft. from S. Line

330 Ft. from E. Line

_____ Ft. from W. Line

			0

TRAPP POOL

Location _____

Rig up _____

Drilling and Remarks:

Liams 3/30
6" 08400
Refr sol cas 3140-45
" " 3140-50
" " 3140-50
5300 acid
Pump 366 10/1
392 Gr.

RECORD

Cased _____ in., _____ ft.

Sand _____

Gas _____

Oil _____

Total Depth 3482

PRODUCTION

1st 24 hrs. Nat. _____

1st 24 hrs. after shot _____

Gas _____ Cu. Ft.

Dry Hole _____

Abandoned _____

Date

OCT 8 1941 19

S. J. LEWIS Scout