

Sec. 15 Twp. 29 Range 7E

1 Sumwalt

Kansas Geological Society


Brown Ranch Oil

Skelly Scout Tickets

Map No. ----- Sec. 15 Twp. 29 R. 7

Well No. 1 ----- Sumwalt Farm  
Brown Ranch Oil Company

NORTH

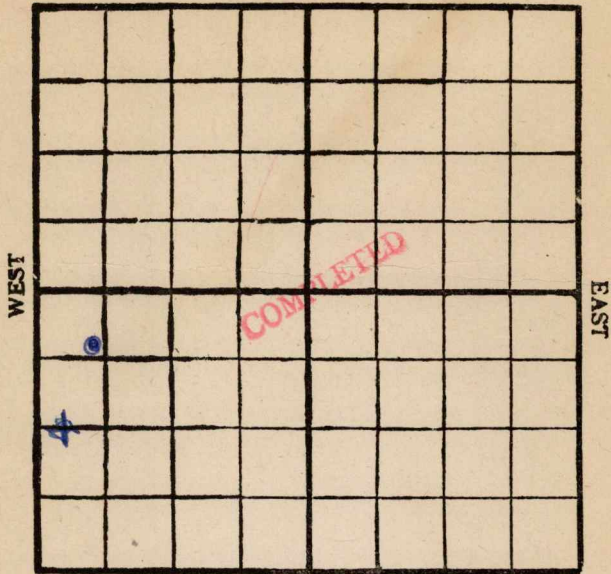

Location -----

Rig Up -----

Drilling Remarks:

Drilling Remarks:




Map No. 1510 Sec. 15 Twp. 29 R. 7

Well No. 1 Summit  
Brown Ranch Company

Contractor

NORTH

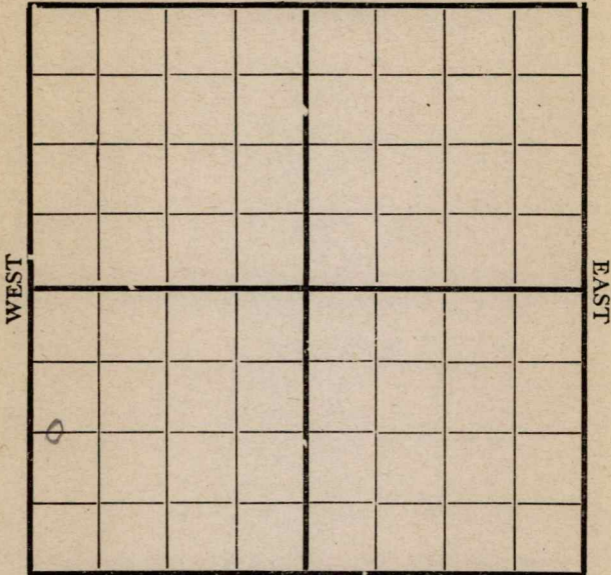

SOUTH

1370 S - 200 W

Location \_\_\_\_\_

Rig up  \_\_\_\_\_

Drilling and Remarks:

**RECORD**

Cased \_\_\_\_\_ in., \_\_\_\_\_ ft.

Sand \_\_\_\_\_

Gas \_\_\_\_\_

Oil \_\_\_\_\_

Total Depth \_\_\_\_\_

**PRODUCTION**

1st 24 hrs. Nat. \_\_\_\_\_

1st 24 hrs. after shot \_\_\_\_\_

Gas \_\_\_\_\_ Cu. Ft.

Dry Hole \_\_\_\_\_

Abandoned \_\_\_\_\_

Date

10/9 1911 J. C. Cuddy Scout

Map No. 1510 Sec. 15 Twp. 29 R. 7


Well No. 1 Summit  
Brown Ranch Oil Company

Contractor

NORTH

WEST

EAST

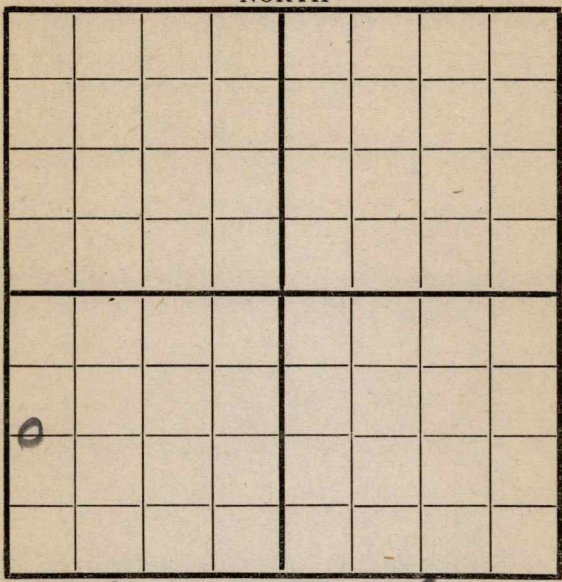

1320 S-200 W SOUTH

Location -----

Rig up -----

Drilling and Remarks:

*Spudding*

**RECORD**

Cased ----- in., ----- ft.

Sand -----

Gas -----

Oil -----

Total Depth -----

**PRODUCTION**

1st 24 hrs. Nat. -----

1st 24 hrs. after shot -----

Gas ----- Cu. Ft.

Dry Hole -----

Abandoned -----

Date

10/16 1918 Candy Scout

Map No. 1510 Sec. 15 Twp. 29 R. 7

Well No. 1 Summit

Brown Ranch Co. Company

Contractor

NORTH

WEST

EAST


SOUTH

1320 S-200 W

Location ✓

Rig up ✓

Drilling and Remarks:

360

RECORD

Cased \_\_\_\_\_ in., \_\_\_\_\_ ft.

Sand \_\_\_\_\_

Gas \_\_\_\_\_

Oil \_\_\_\_\_

Total Depth \_\_\_\_\_

PRODUCTION

1st 24 hrs. Nat. \_\_\_\_\_

1st 24 hrs. after shot \_\_\_\_\_

Gas \_\_\_\_\_ Cu. Ft.

Dry Hole \_\_\_\_\_

Abandoned \_\_\_\_\_

Date

10/23

191

J. Conroy

Scout






Map No. 1510 Sec. 15 Twp. 29 R. 7

Well No. 1 Summit

Brown Ranch Co. Company

Contractor

NORTH

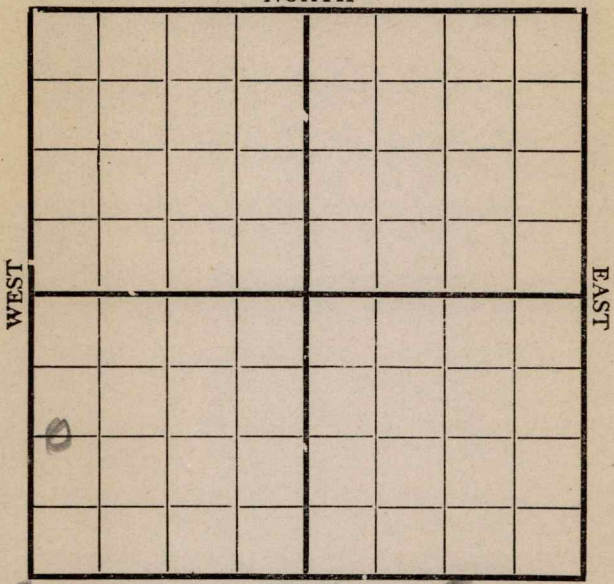

SOUTH

13205200

W

Location \_\_\_\_\_

Rig up \_\_\_\_\_

Drilling and Remarks:

1350

**RECORD**

Cased \_\_\_\_\_ in., \_\_\_\_\_ ft.

Sand \_\_\_\_\_

Gas \_\_\_\_\_

Oil \_\_\_\_\_

Total Depth \_\_\_\_\_

**PRODUCTION**

1st 24 hrs. Nat. \_\_\_\_\_

1st 24 hrs. after shot \_\_\_\_\_

Gas \_\_\_\_\_ Cu. Ft.

Dry Hole \_\_\_\_\_

Abandoned \_\_\_\_\_

Date

11/13 1918 Candy Scout

Map No. K10 Sec. 15 Twp. 29 R. 7

Well No. 1 Summit

Brown Rusch Company

Contractor

NORTH

WEST

EAST


SOUTH

1330 S - 200 W

Location -----

Rig up -----

Drilling and Remarks:

AD 1440

**RECORD**

Cased ----- in., ----- ft.

Sand -----

Gas -----

Oil -----

Total Depth -----

**PRODUCTION**

1st 24 hrs. Nat. -----

1st 24 hrs. after shot -----

Gas ----- Cu. Ft.

Dry Hole -----


Abandoned -----

Date

11/20 J. Conroy Scout

Map No. K10 Sec. 15 Twp. 29 R. 7  
Well No. 1 Summit  
Brown Ranch Co. Company  
Contractor

NORTH

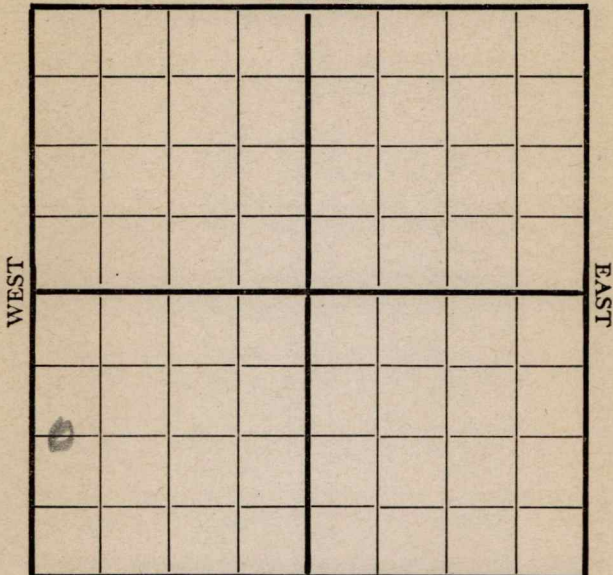

SOUTH

Location -----

Rig up -----

Drilling and Remarks:

2 D 1475

**RECORD**

Cased ----- in., ----- ft.

Sand -----

Gas -----

Oil -----

Total Depth -----

**PRODUCTION**

1st 24 hrs. Nat. -----

1st 24 hrs. after shot -----

Gas ----- Cu. Ft.

Dry Hole -----

Abandoned -----

Date


11/27 191 8 Conroy Scout

Map No. 510 Sec. 5 Twp. 29 R. 7

Well No. 1 Summit  
Brown Ranch Company

Contractor

NORTH

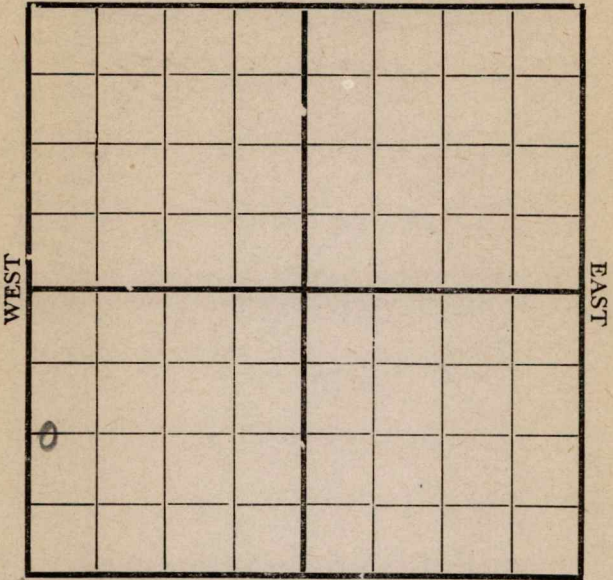

SOUTH

13200 - 200 W

Location \_\_\_\_\_

Rig up \_\_\_\_\_

Drilling and Remarks:

1530

**RECORD**

Cased \_\_\_\_\_ in., \_\_\_\_\_ ft.

Sand \_\_\_\_\_

Gas \_\_\_\_\_

Oil \_\_\_\_\_

Total Depth \_\_\_\_\_

**PRODUCTION**

1st 24 hrs. Nat. \_\_\_\_\_

1st 24 hrs. after shot \_\_\_\_\_

Gas \_\_\_\_\_ Cu. Ft.

Dry Hole \_\_\_\_\_


Abandoned \_\_\_\_\_

Date

12/4 191 J. Conroy Scout

Map No. K10 Sec. 15 Twp. 29 R. 7  
Well No. 15 Summit  
Brown Ranch Company  
Contractor

NORTH

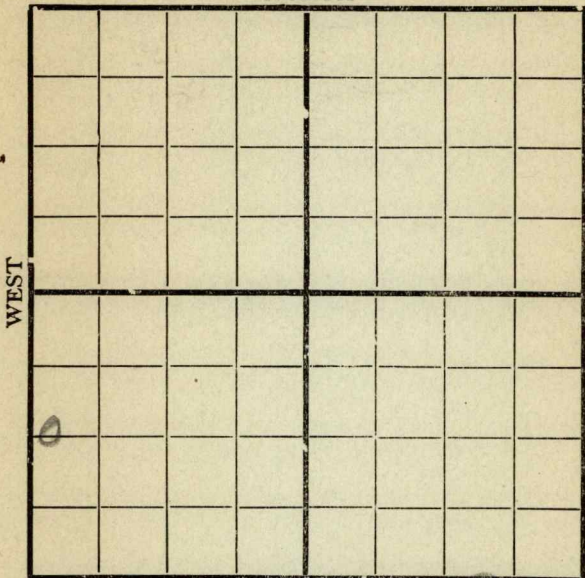

1300-200W SOUTH

Location \_\_\_\_\_  
Rig up \_\_\_\_\_  
Drilling and Remarks:

Trouble  
with 10"  
at 1530

**RECORD**

Cased \_\_\_\_\_ in., \_\_\_\_\_ ft.  
Sand \_\_\_\_\_  
Gas \_\_\_\_\_  
Oil \_\_\_\_\_  
Total Depth \_\_\_\_\_

**PRODUCTION**

1st 24 hrs. Nat. \_\_\_\_\_  
1st 24 hrs. after shot \_\_\_\_\_  
Gas \_\_\_\_\_ Cu. Ft.  
Dry Hole \_\_\_\_\_  
Abandoned \_\_\_\_\_

Date 1 2/4 1918 S. Conroy Scout


Map No. K10 Sec. 15 Twp. 29 R. 7

Well No. Summit

Brown Ranch Company

Contractor

NORTH

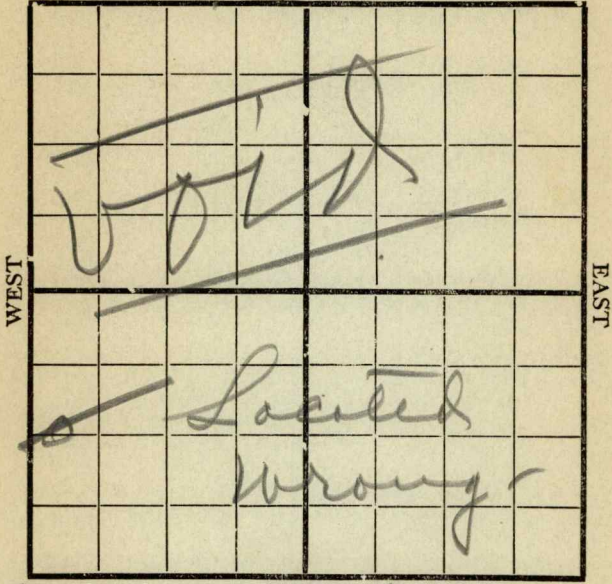

13202-200 W

Location \_\_\_\_\_

Rig up \_\_\_\_\_

Drilling and Remarks:

1665  
Coring

**RECORD**

Cased \_\_\_\_\_ in., \_\_\_\_\_ ft.

Sand \_\_\_\_\_

Gas \_\_\_\_\_

Oil \_\_\_\_\_

Total Depth \_\_\_\_\_

**PRODUCTION**

1st 24 hrs. Nat. \_\_\_\_\_

1st 24 hrs. after shot \_\_\_\_\_

Gas \_\_\_\_\_ Cu. Ft.

Dry Hole \_\_\_\_\_

Abandoned \_\_\_\_\_

Date

12/18 1918 C. C. Coney Scout

Map No. K10 Sec. 15 Twp. 29 R. 7


Well No. 1 Summit  
Brown Ranch Oil Company

Contractor

NORTH

WEST

EAST

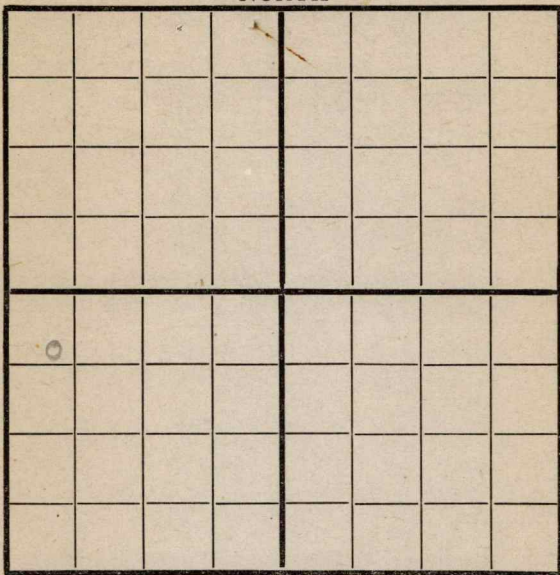

SOUTH

610 N 530 W

Location Corrected

Rig up

Drilling and Remarks:

1665

Hole Coring

**RECORD**

Cased ..... in., ..... ft.

Sand .....

Gas .....

Oil .....

Total Depth .....

**PRODUCTION**

1st 24 hrs. Nat. ....

1st 24 hrs. after shot .....

Gas ..... Cu. Ft.

Dry Hole .....

Abandoned .....

Date

12/18 1918 J. C. Conroy Scout

Map No. K10 Sec. 15 Twp. 29 R. 7

Well No. Sumwalt  
Brown Ranch Company

Contractor

NORTH

WEST

EAST


SOUTH

610 N 530 W

RECORD

Location -----

Cased ----- in., ----- f

Rig up -----

Sand -----

Drilling and Remarks:

Gas -----

Oil -----

DD, 800

Total Depth -----

PRODUCTION

1st 24 hrs. Nat. -----

1st 24 hrs. after shot -----

Gas ----- Cu. F

Dry Hole -----

Abandoned -----

Date

12/25 J. C. Cawley Scot

Map No. K10 Sec. 15 Twp. 29 R. 7

Well No. 1 Summit  
Brown Ranch Company

Contractor

NORTH

WEST

EAST


6104530 W SOUTH

RECORD

Location \_\_\_\_\_

Cased \_\_\_\_\_ in., \_\_\_\_\_ ft

Rig up \_\_\_\_\_

Sand \_\_\_\_\_

Drilling and Remarks:

Gas \_\_\_\_\_

Oil \_\_\_\_\_

Total Depth \_\_\_\_\_

PRODUCTION

1st 24 hrs. Nat. \_\_\_\_\_

1st 24 hrs. after shot \_\_\_\_\_

Gas \_\_\_\_\_ Cu. Ft

Dry Hole \_\_\_\_\_

Abandoned \_\_\_\_\_

SD 1800

Date


1/1 1911 9 Coney Scot

Map No. K 10 Sec. 15 Twp. 29 R. 7

Well No. 1 Summit  
Brown Ranch Company

Contractor

NORTH

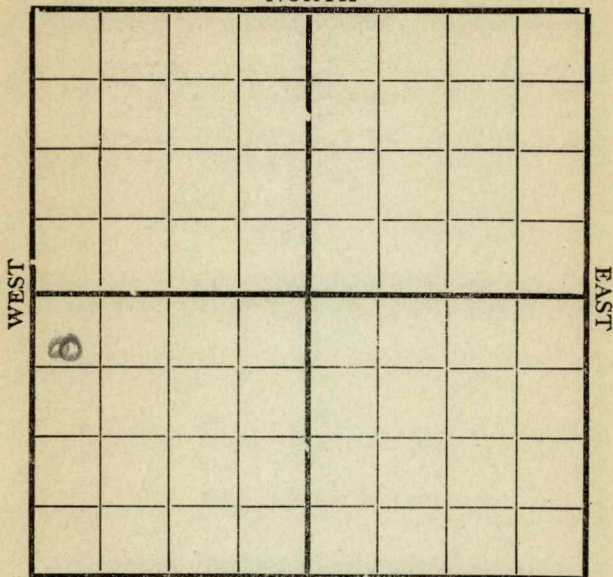

610 A 530 SOUTH W

Location \_\_\_\_\_

Rig up \_\_\_\_\_

Drilling and Remarks:

22 1800

**RECORD**

Cased \_\_\_\_\_ in., \_\_\_\_\_ ft.

Sand \_\_\_\_\_

Gas \_\_\_\_\_

Oil \_\_\_\_\_

Total Depth \_\_\_\_\_

**PRODUCTION**

1st 24 hrs. Nat. \_\_\_\_\_

1st 24 hrs. after shot \_\_\_\_\_

Gas \_\_\_\_\_ Cu. Ft.

Dry Hole \_\_\_\_\_

Abandoned \_\_\_\_\_

Date


1/8

191

J. C. Cady

Scout

Map No. K10 Sec. 15 Twp. 29 R. 7  
Well No. 1 Summit  
Brown Ranch Company  
Contractor

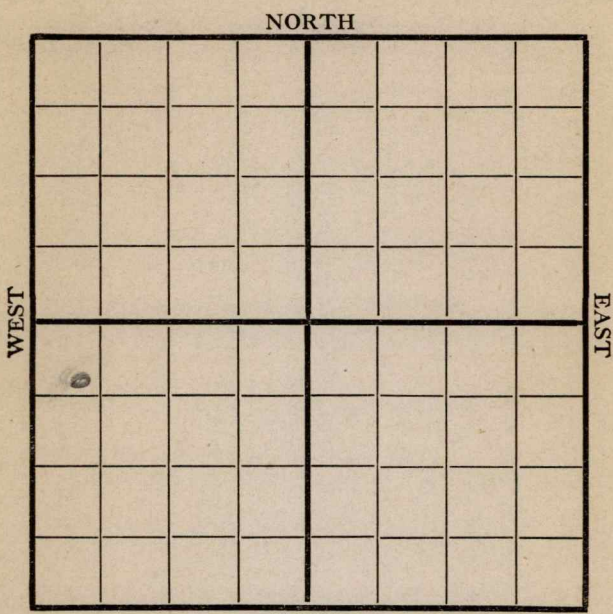

610 N 530 W

Location -----

Rig up -----

Drilling and Remarks:

22,180

**RECORD**

Cased ----- in., ----- ft.

Sand -----

Gas -----

Oil -----

Total Depth -----

**PRODUCTION**

1st 24 hrs. Nat. -----

1st 24 hrs. after shot -----

Gas ----- Cu. Ft.

Dry Hole -----

Abandoned -----

Date


1/15 1919 Candy Scout

Map No. K10 Sec. 15 Twp. 29 R. 7

Well No. 1 Summit  
Brown Ranch Company

Contractor

NORTH

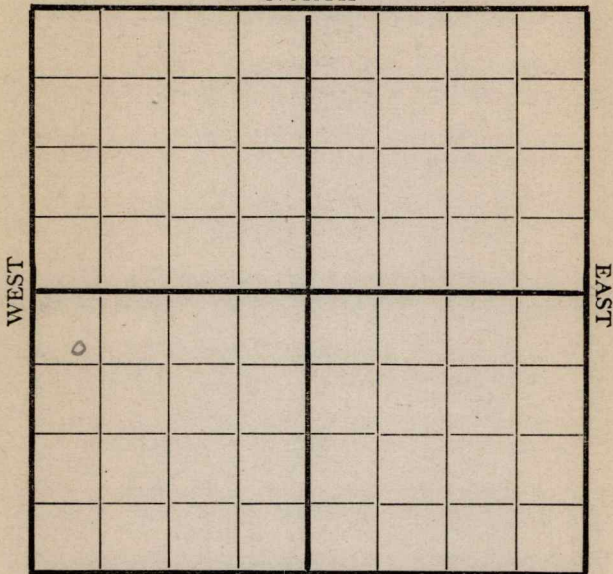

SOUTH

610 N 530 W

Location -----

Rig up -----

Drilling and Remarks:

AD 1800

**RECORD**

Cased ----- in., ----- ft.

Sand -----

Gas -----

Oil -----

Total Depth -----

**PRODUCTION**

1st 24 hrs. Nat. -----

1st 24 hrs. after shot -----

Gas ----- Cu. Ft.

Dry Hole -----

Abandoned -----

Date


1/22 1919 Quincy Scout

Map No. K10 Sec. 15 Twp. 29 R. 7

Well No. 1 Summit  
Crown Ranch Company

Contractor

NORTH

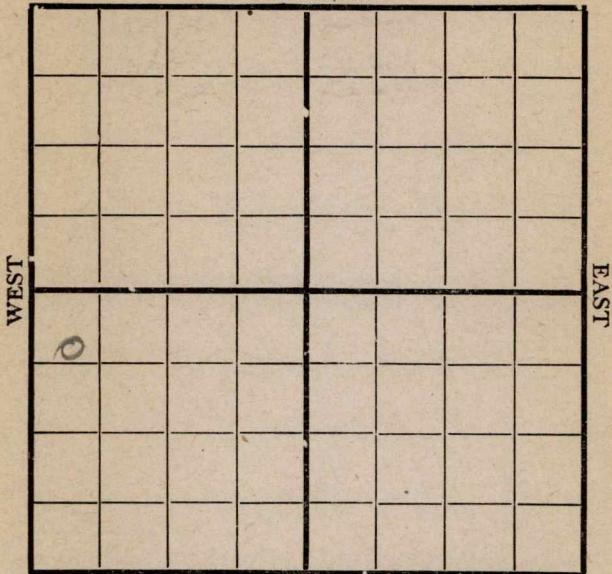

610 N

SOUTH

530 W

Location \_\_\_\_\_

Rig up \_\_\_\_\_

Drilling and Remarks:

1830

**RECORD**

Cased \_\_\_\_\_ in., \_\_\_\_\_ ft.

Sand \_\_\_\_\_

Gas \_\_\_\_\_

Oil \_\_\_\_\_

Total Depth \_\_\_\_\_

**PRODUCTION**

1st 24 hrs. Nat. \_\_\_\_\_

1st 24 hrs. after shot \_\_\_\_\_

Gas \_\_\_\_\_ Cu. Ft.

Dry Hole \_\_\_\_\_

Abandoned \_\_\_\_\_

Date

Jan 29 1919

**Pyle**


Scout

Map No. K10 Sec. 15 Twp. 29 R. 7

Well No. 1 Summit  
Brown Ranch Company

Contractor

NORTH

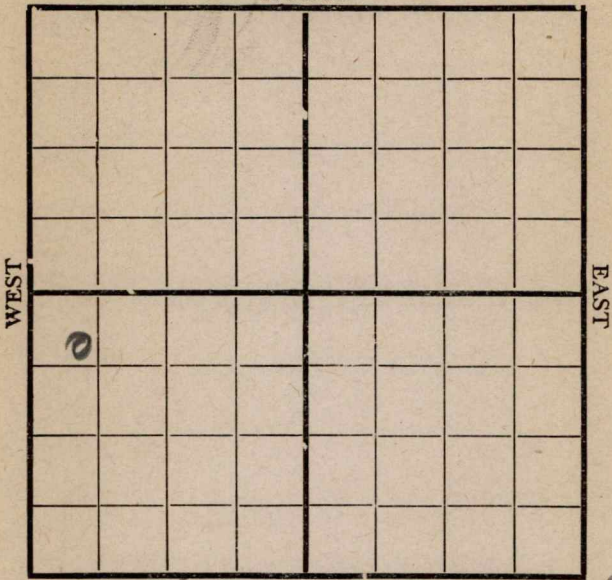

610 N

SOUTH

530 W

Location \_\_\_\_\_

Rig up \_\_\_\_\_

Drilling and Remarks:

*fish for  
21 R @  
1830'*

**RECORD**

Cased \_\_\_\_\_ in., \_\_\_\_\_ ft.

Sand \_\_\_\_\_

Gas \_\_\_\_\_

Oil \_\_\_\_\_

Total Depth \_\_\_\_\_

**PRODUCTION**

1st 24 hrs. Nat. \_\_\_\_\_

1st 24 hrs. after shot \_\_\_\_\_

Gas \_\_\_\_\_ Cu. Ft.

Dry Hole \_\_\_\_\_

Abandoned \_\_\_\_\_

Date


2/4 1919

**Pyle**

Scout



Map No. K10 Sec. 15 Twp. 29<sup>s</sup> R. 7<sup>E</sup>  
 Well No. 1 Sunwalk  
Brown Ranch Company  
 Contractor

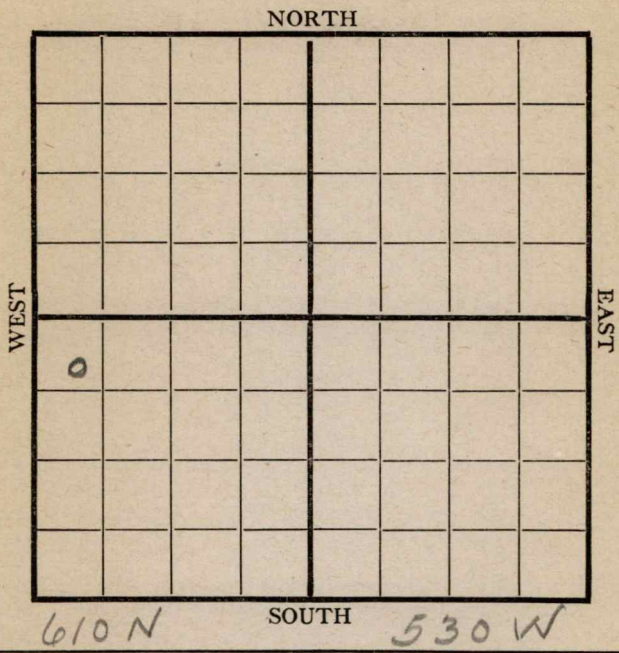

Location \_\_\_\_\_  
 Rig up \_\_\_\_\_  
 Drilling and Remarks:  
set 6" @  
2300'

**RECORD**

Cased \_\_\_\_\_ in., \_\_\_\_\_ ft.  
 Sand \_\_\_\_\_  
 Gas \_\_\_\_\_  
 Oil \_\_\_\_\_  
 Total Depth \_\_\_\_\_

---

**PRODUCTION**

1st 24 hrs. Nat. \_\_\_\_\_  
 1st 24 hrs. after shot \_\_\_\_\_  
 Gas \_\_\_\_\_ Cu. Ft.  
 Dry Hole \_\_\_\_\_  
 Abandoned \_\_\_\_\_


Date 2/19 1919 Pyle Scout

Map No. K10 Sec. 15 Twp. 29<sup>s</sup> R. 7<sup>E</sup>

Well No. 1 Summerville  
Brown Ranch Company

Contractor

NORTH

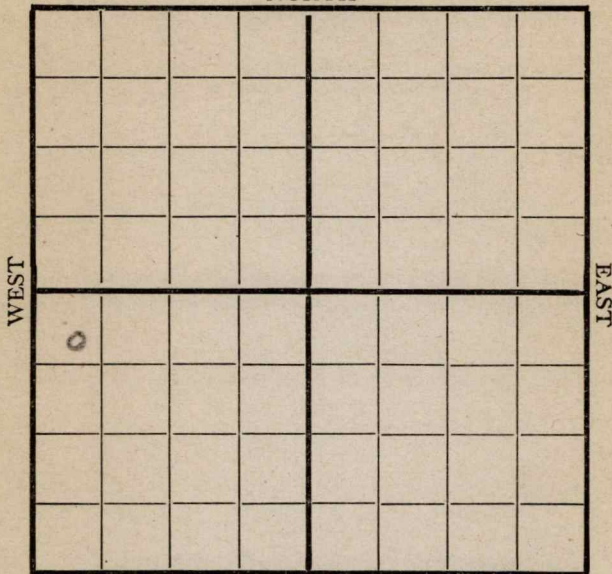

610 N

SOUTH

530 W

Location \_\_\_\_\_

Rig up \_\_\_\_\_

Drilling and Remarks:

2550'

**RECORD**

Cased 6 in., 2300' ft.

Sand \_\_\_\_\_

Gas \_\_\_\_\_

Oil \_\_\_\_\_

Total Depth \_\_\_\_\_

**PRODUCTION**

1st 24 hrs. Nat. \_\_\_\_\_

1st 24 hrs. after shot \_\_\_\_\_

Gas \_\_\_\_\_ Cu. Ft.

Dry Hole \_\_\_\_\_

Abandoned \_\_\_\_\_

Date

2/26 1919


Pyle Scout

Map No. K10 Sec. 15 Twp. 29<sup>S</sup> R. 7<sup>E</sup>

Well No. 1 Sunwalt  
Brown Ranch Company

Contractor

NORTH

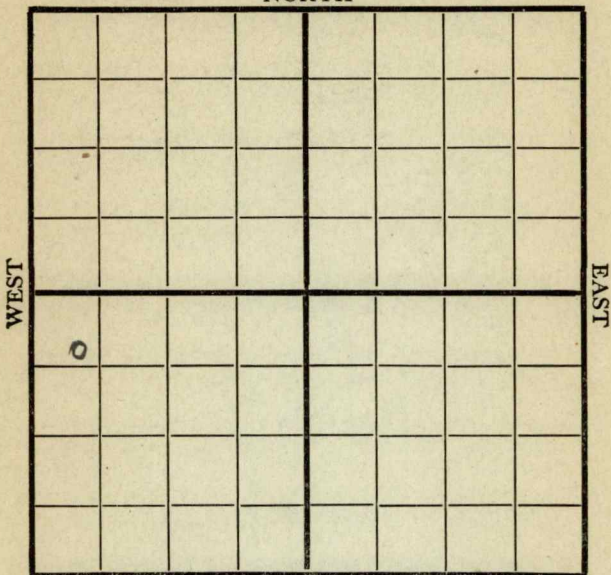

610 N

SOUTH

530 W

Location .....

Rig up .....

Drilling and Remarks:

Wlg @ 2600  
5<sup>3</sup>/<sub>16</sub> hole

RECORD

Cased..... in., ..... ft.

Sand.....

Gas.....

Oil.....

Total Depth.....

PRODUCTION

1st 24 hrs. Nat. ....

1st 24 hrs. after shot.....

Gas..... Cu. Ft.

Dry Hole.....

Abandoned.....

Date

3/5 191 9

**Pyle**

Scout




Map No. K10 Sec. 15 Twp. 29 R. 7

Well No. 1 Sumwalt  
Brown Ranch Company

Contractor

NORTH

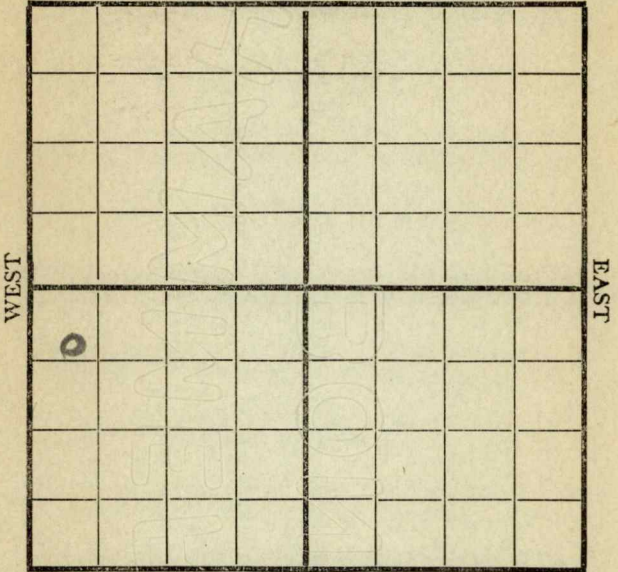

530 W

SOUTH

610 N

Location -----

Rig up -----

Drilling and Remarks:

2750'

RECORD

Cased ----- in., ----- ft.

Sand -----

Gas -----

Oil -----

Total Depth -----

PRODUCTION

1st 24 hrs. Nat. -----

1st 24 hrs. after shot -----

Gas ----- Cu. Ft.

Dry Hole -----

Abandoned -----

Date

3/20 1919

**Pyle**

Scout

Map No. K10 Sec. 15 Twp. 29 R. 7

Well No. 1 Summit

Brown Ranch Company

Contractor

NORTH

WEST

EAST


530 W

SOUTH

610 N

Location \_\_\_\_\_

Rig up \_\_\_\_\_

Drilling and Remarks:

U. R 5" to 27 50

**RECORD**

Cased \_\_\_\_\_ in., \_\_\_\_\_ ft.

Sand \_\_\_\_\_

Gas \_\_\_\_\_

Oil \_\_\_\_\_

Total Depth \_\_\_\_\_

**PRODUCTION**

1st 24 hrs. Nat. \_\_\_\_\_

1st 24 hrs. after shot \_\_\_\_\_

Gas \_\_\_\_\_ Cu. Ft.

Dry Hole \_\_\_\_\_

Abandoned \_\_\_\_\_

Date

3/26

191 9

**Pyle**

Scout




Map No. K10 Sec. 15 Twp. 29 R. 7

Well No. 1 Summit  
Brown Ranch Company

Contractor

NORTH

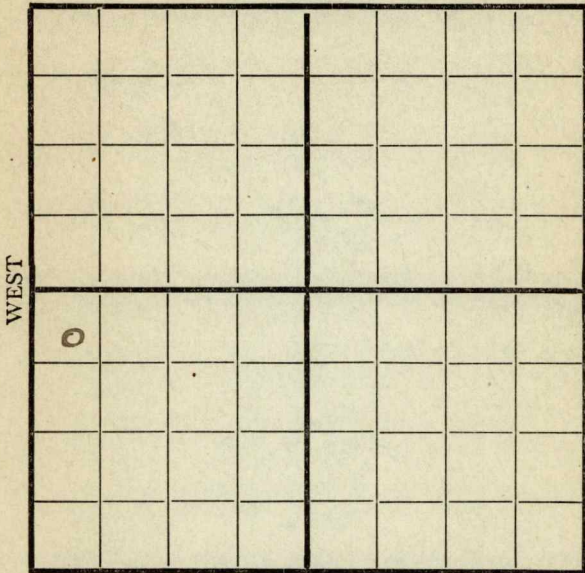

530 W

SOUTH

610 N

Location \_\_\_\_\_

Rig up \_\_\_\_\_

Drilling and Remarks:

D. D. C.  
2960

**RECORD**

Cased \_\_\_\_\_ in., \_\_\_\_\_ ft.

Sand \_\_\_\_\_

Gas \_\_\_\_\_

Oil \_\_\_\_\_

Total Depth \_\_\_\_\_

**PRODUCTION**

1st 24 hrs. Nat. \_\_\_\_\_

1st 24 hrs. after shot \_\_\_\_\_

Gas \_\_\_\_\_ Cu. Ft.

Dry Hole \_\_\_\_\_

Abandoned \_\_\_\_\_

Date

4/12 1919

**Pyle**

Scout


Map No. K10 Sec. 15 Twp. 29 R. 7

Well No. 1 Summit

Brown Ranch Oil Company

Contractor

NORTH

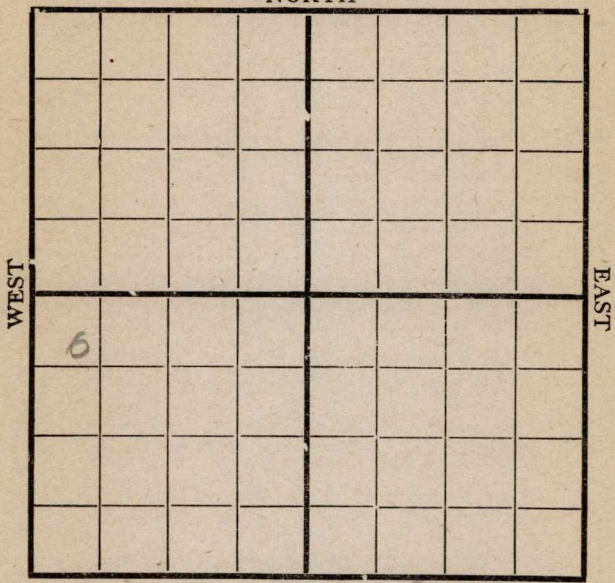

610 N SOUTH 530 W

Location \_\_\_\_\_

Rig up \_\_\_\_\_

Drilling and Remarks:

2960  
S.O.

**RECORD**

Cased \_\_\_\_\_ in., \_\_\_\_\_ ft.

Sand \_\_\_\_\_

Gas \_\_\_\_\_

Oil \_\_\_\_\_

Total Depth \_\_\_\_\_

**PRODUCTION**

1st 24 hrs. Nat. \_\_\_\_\_

1st 24 hrs. after shot \_\_\_\_\_

Gas \_\_\_\_\_ Cu. Ft.

Dry Hole \_\_\_\_\_

Abandoned \_\_\_\_\_

Date

4/15 1919

**Pyle**

Scout


Map No. K10 Sec. 15 Twp. 29 R. 7

Well No. 1 Summit

Brown Ranch Oil Company

Contractor

NORTH

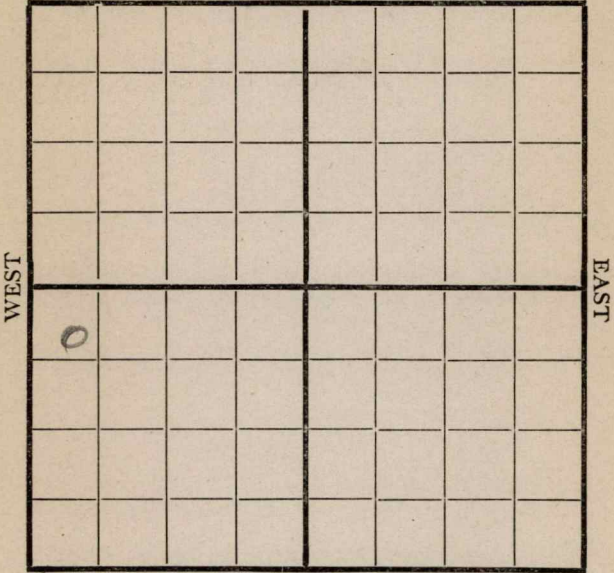

610 N

SOUTH

530 W

Location \_\_\_\_\_

Rig up \_\_\_\_\_

Drilling and Remarks:

21 R. 5 <sup>3</sup>/<sub>16</sub>

to 2960'

**RECORD**

Cased \_\_\_\_\_ in., \_\_\_\_\_ ft.

Sand \_\_\_\_\_

Gas \_\_\_\_\_

Oil \_\_\_\_\_

Total Depth \_\_\_\_\_

**PRODUCTION**

1st 24 hrs. Nat. \_\_\_\_\_

1st 24 hrs. after shot \_\_\_\_\_

Gas \_\_\_\_\_ Cu. Ft.

Dry Hole \_\_\_\_\_

Abandoned \_\_\_\_\_

Date

4/ \_\_\_\_\_ 191 9

**Pyle**

Scout


22

Map No. K10 Sec. 15 Twp. 29 R. 7

Well No. 1 Sumwalt  
Brown Ranch Oil Company

Contractor \_\_\_\_\_

NORTH

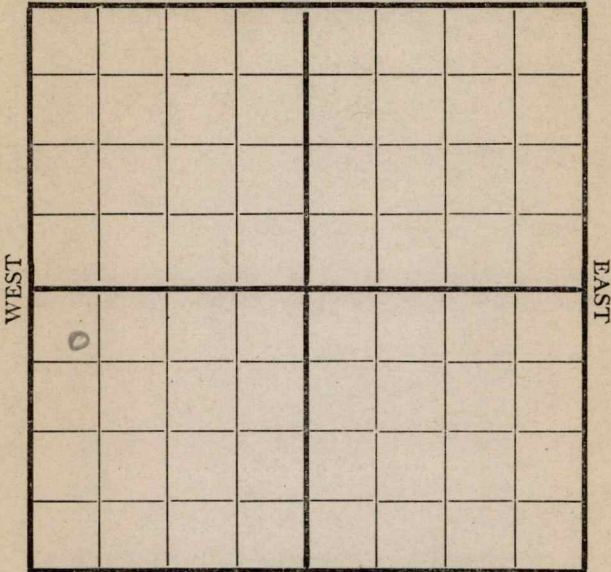

610 N

SOUTH

530 W

Location \_\_\_\_\_

Rig up \_\_\_\_\_

Drilling and Remarks:

3100'

**RECORD**

Cased \_\_\_\_\_ in., \_\_\_\_\_ ft.

Sand \_\_\_\_\_

Gas \_\_\_\_\_

Oil \_\_\_\_\_

Total Depth \_\_\_\_\_

**PRODUCTION**

1st 24 hrs. Nat. \_\_\_\_\_

1st 24 hrs. after shot \_\_\_\_\_

Gas \_\_\_\_\_ Cu. Ft.

Dry Hole \_\_\_\_\_

Abandoned \_\_\_\_\_

Date

5/2 1919


Pyle Scout

Map No. K10 Sec. 15 Twp. 29 R. 7

Well No. 1 Summit  
Brown Ranch O & G Company

Contractor

NORTH

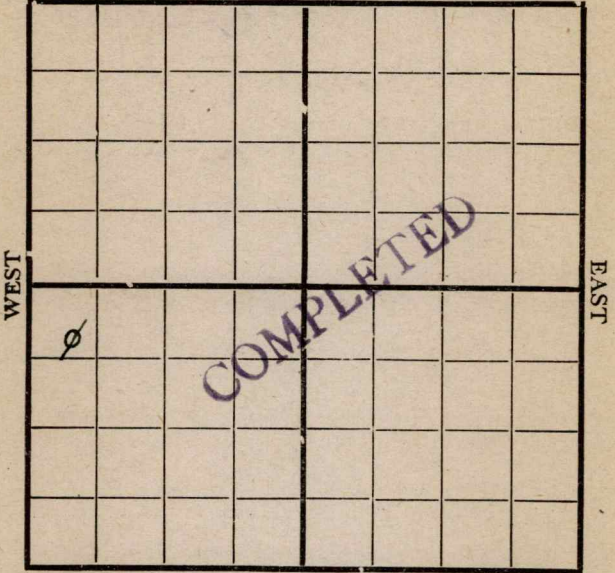

610 N

SOUTH

580 W

Location .....

Rig up .....

Drilling and Remarks:

**RECORD**

Cased ..... in., ..... ft.

Sand .....

Gas .....

Oil .....

Total Depth .....

**PRODUCTION**

1st 24 hrs. Nat. ....

1st 24 hrs. after shot .....

Gas ..... Cu. Ft.

Dry Hole 3250 .....

Abandoned .....

Date

5/18

1919

Pyle

Scout