




Sec. 28 Twp. 16 R. 13W

Well No. #3 Heflin Farm
M. B. Armer Company

Trapp Pool

NORTH

990' Ft. from N. Line

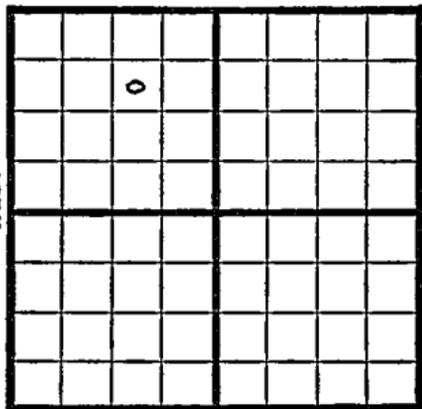

Ft. from S. Line

990' Ft. from E. Line

Ft. from W. Line

SW NE NW

SOUTH

1948

Eli 1966'

REPORT

8/18

8" @ 186'

Anhy. 900'

Drig. 1840'

8/25

Drig 3182'

9/1

rb. 3431'

TD 3456'

Aband.

ABANDONED

Barton County Kansas State

Map No. _____ Sec. 28 Twp. 16 R. 13W

Well No. 3 Heflin

M. B. Armer Company

FIRST REPORT Contractor

SW NE NW

SECTION PLAT

990 Ft. from N. Line

_____ Ft. from S. Line

990 Ft. from E. Line

_____ Ft. from W. Line

Trapp Pool

Remarks:

8" @ 186 any 900 drlg. 1840!

Date
AUG 18 1948

Scout S. J. LEWIS

Barton County Kansas State

Map No. 73 Sec. 28 Twp. 16 R. 13W

Well No. 3 Heflin

M. B. Armer Company

ABANDONED Contractor

SW NE NW

E. 1966
SECTION PLAT

990 Ft. from N. Line

 Ft. from S. Line

990 Ft. from E. Line

 Ft. from W. Line

		o					

Trapp Pool

Remarks:

CR 3431

YD 3456

Date
SEP 1 1948

Scout
S. J. LEWIS