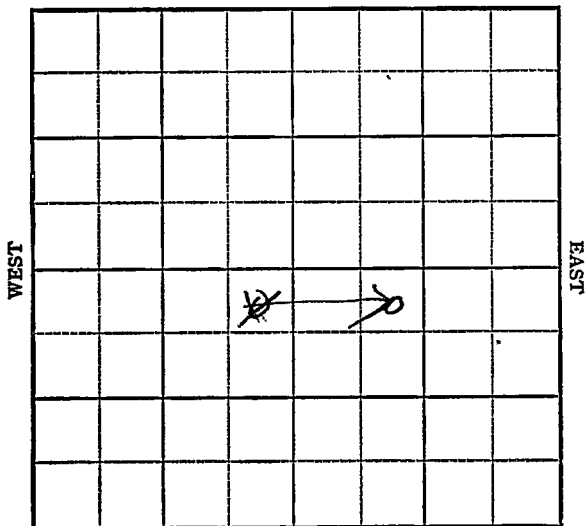


KANSAS Barton

Section 28 Township 16 Range 13WWell No. ~~1 Stoskopf~~ 3 RedetzkeCompany Aledo & Lindas

Ainsworth Pool

NORTH



SOUTH

Sec. 28 Twp. 16 R. 13W

Well No. ~~Stoskopf~~ #3 Redetzke Farm

Aledo & Lindas Company

Ainsworth Pool

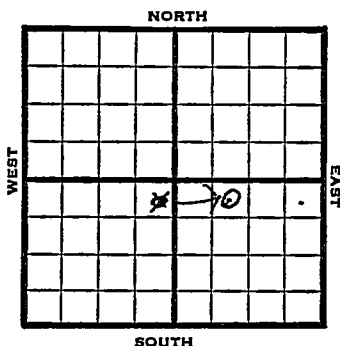
330 Ft. from N. Line

_____ Ft. from S. Line

_____ Ft. from E. Line

990' Ft. from W. Line

NE NW SE



1948 Elev. 1964' REPORT

11/16	Location
11/23	"
11/30	8" @ 216'
	Drlg 2850'
12/8	Drlg 3439'
12/15	Lansing 3206'
	Arb. 3633' SWD
12/22	"
12/29	"
1949	
1/5	Arb. 3416'
	5" @ 3628'
	3000 acid
	SWD
	TD 3784'
	ABANDONED

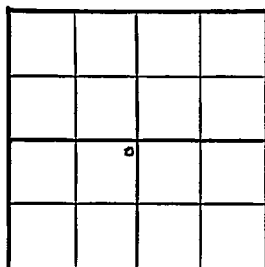
Map No. _____ Sec. 28 Twp. 16 R. 13WWell No. 1 StoskopfAledo & Lindas Company

FIRST REPORT

Contractor

NE SW

SECTION PLAT

330 Ft. from N. Line_____
Ft. from S. Line330 Ft. from E. Line_____
Ft. from W. LineBarton CountyLocation X

Rig up _____

Drilling and Remarks:

RECORD

Cased _____ in., _____ ft.

Sand _____

Gas _____

Oil _____

Total Depth _____

PRODUCTION

1st 24 hrs. Nat. _____

1st 24 hrs. after shot _____

Gas _____ Cu. Ft.

Dry Hole _____

Abandoned _____

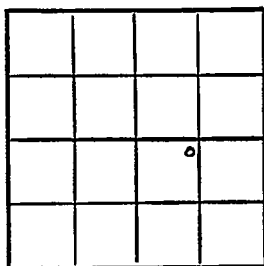
Date

NOV 17 1948 19S. J. LEWIS Scout

Map No. 73 Sec. 28 Twp. 16 R. 13WWell No. 3 RedetzkeAledo & Lindas CompanyCORRECTION Contractor

NE NW SE

SECTION PLAT

330 Ft. from N. Line Ft. from S. Line Ft. from E. Line990 Ft. from W. Line

Barton County

Location _____

Rig up _____

Drilling and Remarks:

Reported as

#1 Stoskopf

NE SW

RECORD

Cased _____ in., _____ ft.

Sand _____

Gas _____

Oil _____

Total Depth _____

PRODUCTION

1st 24 hrs. Nat. _____

1st 24 hrs. after shot _____

Gas _____ Cu. Ft.

Dry Hole _____

Abandoned _____

Date

NOV 23 1948 19

S. J. LEWIS Scout

Kansas

Ainsworth Pool

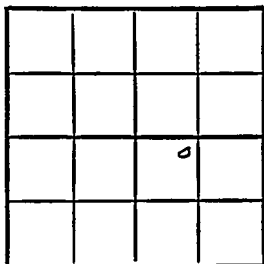
Map No. 72 Sec. 28 Twp. 16 R. 13WWell No. 3 RedetzkeAlado & Lindas

Company

ABANDONED

Contractor

NE NW SE

E. 11964
SECTION PLAT330 Ft. from N. Line Ft. from S. Line Ft. from E. Line990 Ft. from W. LineBarton CountyLocation Rig up

Drilling and Remarks:

Cor 43416
51 03628
3000 acid
SWD

RECORDCased in., ft.Sand Gas Oil Total Depth 3784**PRODUCTION**1st 24 hrs. Nat. 1st 24 hrs. after shot Gas Cu. Ft.Dry Hole Abandoned

Date

JAN 5 1949 19S. J. LEWIS Scout