


Section 9 Township 29 Range 7 E

Well No. # 1 Bolan

Company Augusta Oil

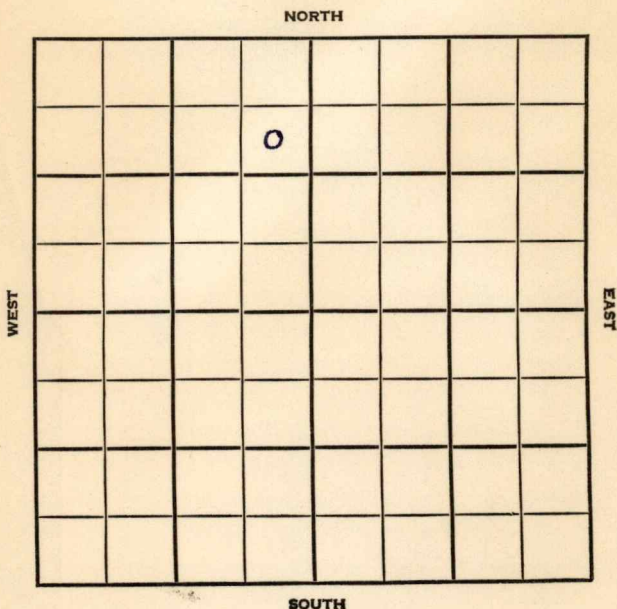

Butler **KANSAS**

SEC.	TWP.	R.
9	29	7 E

WELL NO. # 1 Bolan FARM

COMPANY
Augusta Oil

CONTRACTOR
Co. tools

Wildcat


990 _____ Ft. from N. Line

_____ Ft. from S. Line

330 _____ Ft. from E. Line

_____ Ft. from W. Line

SE NE NW

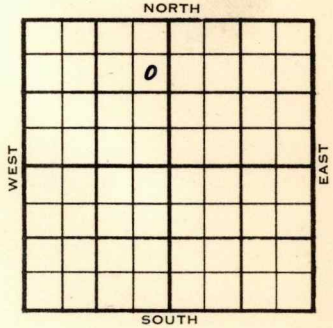

1954

ELEVATION
1463'

REPORT

12/29

D & A. TD 2840' **KC 2090'**
Oswego 2475' Cherokee 2660'
Miss. 2805' TD 2840'
 D & A

FIRST REPORT



ABANDONED

County **Butler** State **Kansas**

Sec. **9** (Blk. Twp.) **29** (Sur. Rge.) **7E** Map No.

Operator **Augusta Oil**

Well No. **1** Farm **Bolan**

Elev. **1463** Location **SE NE NW**



990 Ft. From **N** Line **NW**

330 Ft. From **E** Line Quarter

Ist. Report **DEC 29 1954**

Completion **DEC 29 1954**

Remarks **Wildcat**

Co. tools

Spudding Date

Drlg. Data **D & A** **TD 2840**

KC 2090 **Oswego 2475** **Cherokee 2660**

Miss. 2805 **TD 2840**

D & A

FABEN GILSTRAP