


Section 28 Township 16 Range 13W

Well No. 4 Stoskopf

Company Continental

Trapp
NORTH

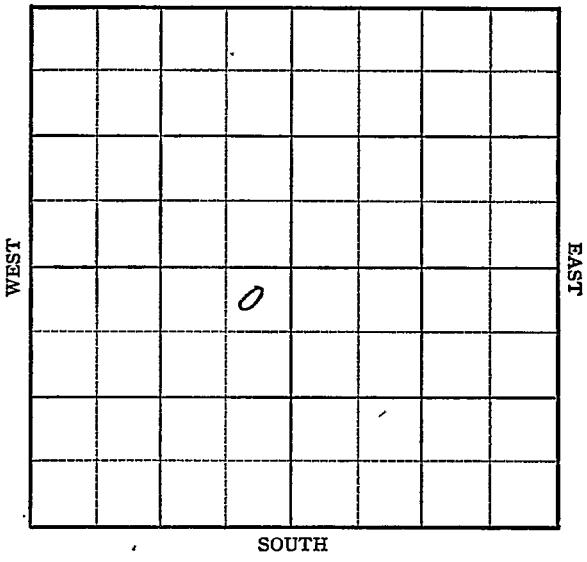

Barton

KANSAS

Sec. 28 Twp. 16 R. 13W

Well No. #4 Stoskopf Farm

Continental Company

Trapp Pool

330'

Ft. from N. Line


Ft. from S. Line

330'

Ft. from E. Line

Ft. from W. Line

NE SW

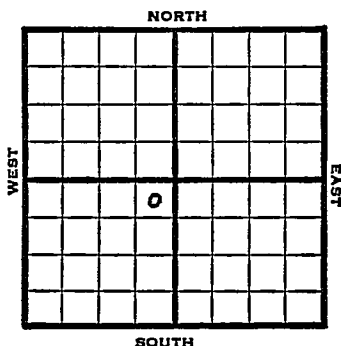

1949

Elev 1967' REPORT

7/20

10" @ 366'

Drlg. 2186'

7/27

Lansing 3180'

Arb. 3420'

TD 3423'

7" @ 3421'

8/3

Swb 40 bbls oil in 2 hrs.

8/10

"

8/17

"

8/24

"

8/31

TD 3423'

Arb. 3420'

7" @ 3421'

Pump 261 Oil Pot

38° Gr.

Comp

COMPLETED

Kansas

Trapp Pool

Map No. _____ Sec. 28 Twp. 16 R. 13W

Well No. 4 Stoskopf

Continental

Company

Contractor

NE SW

FIRST REPORT
SECTION PLAT

330

Ft. from N. Line

Ft. from S. Line

300

Ft. from E. Line

Ft. from W. Line

	o		

Barton County

Location _____

Rig up _____

Drilling and Remarks:

10" @ 366'

drlg. 2186

RECORD

Cased _____ in., _____ ft.

Sand _____

Gas _____

Oil _____

Total Depth _____

PRODUCTION

1st 24 hrs. Nat. _____

1st 24 hrs. after shot _____

Gas _____ Cu. Ft.

Dry Hole _____

Abandoned _____

Date

JUL 20 1949

19

S. J. LEWIS


Scout

Kansas

Map No. 173 Sec. 28 Twp. 16 R. 13WWell No. 4 StoskopfContinental Company**COMPLETE**

Contractor

NE SW

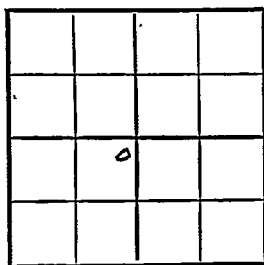E. 1767
SECTION PLAT330 Ft. from N. Line Ft. from S. Line330 Ft. from E. Line Ft. from W. Line

Barton County

RECORDLocation Cased in., ft.Rig up Sand

Drilling and Remarks:

Gas *Cr x 3420*Oil *7' @ 3421.*Total Depth 3423*Prod 26/ oil 128***PRODUCTION**1st 24 hrs. Nat. 1st 24 hrs. after shot Gas Cu. Ft.Dry Hole Abandoned *380 lb*

Date

AUG 31 1949

19

S. J. LEWIS

Scout