

30

29

Cross
Brown Ranch

Company

EAST

SOUTH

Rig Up -----

Drilling Remarks:

PRODUCTION

1st 24 hrs. Nat. _____

1st 24 hrs. after shot-----

Gas_____cu. ft

Dry Hole _____

Abandoned -----

Map No. _____ Sec. 16 Twp. 29 R. 7Well No. 1 Craft FarmBrown Ranch Company

Contractor _____

NW Quarter1120 Ft. from N. Line

Ft. from S. Line

Ft. from E. Line

200 Ft. from W. Line

Date _____ REPORT

1911 AD 15001920 AD 100011/8 AD 100015 AD 100022 AD 100029 AD 100012/6 AD 100013 Shutdown 100020 ✓ ✓ ✓24 " " 10002/2 ✓ ✓ ✓11 4 R. 10" to 13253/3 N 24 152023 ✓ 15804/2 ✓ 16209 ✓ 17105/4 4R 8 1/4 24156/5 AD N 9 W. 2950 (error)7/6 AD 2780 small show11 Trying to shut off water 278024 N. R. 5" to 2835
over

8/2 - H. R. 5" to 2870

8/4 — — —

8/10 S.D. @ 2870'

8/25 - dry hole 3173

Map No. K 10 Sec. 16 Twp. 29 R. 7Well No. 1 Craft
Brown Ranch 019 Company

Contractor

NORTH

0							

WEST

EAST

SOUTH

1120 N200 W

Location _____

Rig up ☒

Drilling and Remarks:

RECORD

Cased _____ in., _____ ft.

Sand _____

Gas _____

Oil _____

Total Depth _____

PRODUCTION

1st 24 hrs. Nat. _____

1st 24 hrs. after shot _____

Gas _____ Cu. Ft.

Dry Hole _____

Abandoned _____

Date

8/151919


Pyle

Scout

Sec. 16 Twp. 29 Rge. 7
Owner Brown Ranch J & L
Farm Craft Well No. 1
Contractor _____

Feet from lines, N. 1120 E. _____ S. _____ W. 200

Casing used _____
15½ _____ ft.
12½ _____ ft.
10 _____ ft.
8¼ _____ ft.
6⅝ _____ ft.
5 3-16 _____ ft.
Location _____
Rig ☒ _____

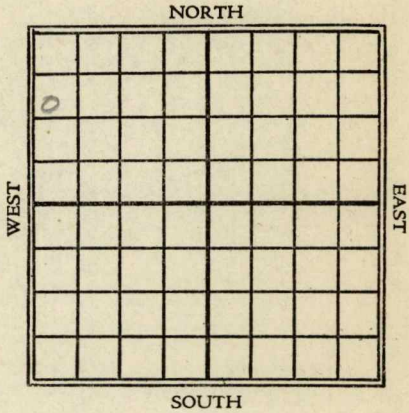

Drilling at _____ ft. Fishing at _____ ft.
Total Depth _____ Completed _____
1st 24 Hrs. Nat. _____ Producing _____
1st 24 Hrs. Shot _____ Dry Hole _____
Gas _____ Cu. ft. Abandoned _____
Sands — give name and depth. Top _____ Bottom _____

Date of Report 7/22
Reported by Pyle

Map No. K10 Sec. 16 Twp. 29 R. 7Well No. 1 CraftBrown Ranch Co Company

Contractor

SECTION PLAT

1120 Ft. from N. Line

Ft. from S. Line

Ft. from E. Line

200 Ft. from W. Line

0			

Location

Rig up ☒

Drilling and Remarks:

RECORD

Cased _____ in., _____ ft.

Sand _____

Gas _____

Oil _____

Total Depth _____

PRODUCTION

1st 24 hrs. Nat. _____

1st 24 hrs. after shot _____

Gas _____ Cu. Ft.

Dry Hole _____

Abandoned _____

Date

29 1919Pyle

Scout

Map No. K 10 Sec. 16 Twp. 29 R. 7Well No. 1 Craft
Brown Ranch Oil Company

Contractor _____

SECTION PLAT

1120 Ft. from N. Line

_____ Ft. from S. Line

_____ Ft. from E. Line

200 Ft. from W. Line

0			

Location _____

Rig up _____

Drilling and Remarks:

Spud

RECORD

Cased _____ in., _____ ft.

Sand _____

Gas _____

Oil _____

Total Depth _____

PRODUCTION

1st 24 hrs. Nat. _____

1st 24 hrs. after shot _____

Gas _____ Cu. Ft.

Dry Hole _____

Abandoned _____

Date

9/3 1919 Pyle Scout

Map No. 110 Sec. 16 Twp. 29 R. 7Well No. 1 CraftBrown Ranch Oil Company

Contractor

SECTION PLAT

1120 Ft. from N. Line

Ft. from S. Line

Ft. from E. Line

200 Ft. from W. Line

0			

Location

Rig up

Drilling and Remarks:

*Spud &
D.D.*

RECORD

Cased _____ in., _____ ft.

Sand _____

Gas _____

Oil _____

Total Depth _____

PRODUCTION

1st 24 hrs. Nat. _____

1st 24 hrs. after shot _____

Gas _____ Cu. Ft.

Dry Hole _____

Abandoned _____

Date

9/15 1919

Pyke Scout

Map No. K10 Sec. 16 Twp. 29 R. 7Well No. 1 Craft
Brown Ranch Oil Company

Contractor

SECTION PLAT

1120 Ft. from N. Line

Ft. from S. Line

Ft. from E. Line

200 Ft. from W. Line

0			

Location

Rig up

Drilling and Remarks:

Spud &
S.D.
for water

RECORD

Cased _____ in., _____ ft.

Sand _____

Gas _____

Oil _____

Total Depth _____

PRODUCTION

1st 24 hrs. Nat. _____

1st 24 hrs. after shot _____

Gas _____ Cu. Ft.

Dry Hole _____

Abandoned _____

Date

9 / 20 1919

Pyle

Scout

Map No. K 10 Sec. 16 Twp. 19 R. 7Well No. 1 CraftBrown Ranch O & G Company

Contractor

SECTION PLAT

1120 Ft. from N. Line

Ft. from S. Line

Ft. from E. Line

206 Ft. from W. Line

0			

Location

Rig up

Drilling and Remarks:

RECORD

Cased in., ft.

Sand

Gas

Oil

Total Depth

PRODUCTION

1st 24 hrs. Nat.

1st 24 hrs. after shot

Gas Cu. Ft.

Dry Hole

Abandoned

Date

Pyle

9/27 1919

Scout

Map No. K10 Sec. 16 Twp. 29 R. 7

Well No. 1 Craft
Brown Ranch Company

Contractor

SECTION PLAT

1120 Ft. from N. Line

_____ Ft. from S. Line

_____ Ft. from E. Line

200 Ft. from W. Line

0			

RECORD

Location _____

Rig up _____

Drilling and Remarks:

Cased _____ in., _____ ft.

Sand _____

Gas _____

Oil _____

Total Depth _____

PRODUCTION

1st 24 hrs. Nat. _____

1st 24 hrs. after shot _____

Gas _____ Cu. Ft.

Dry Hole _____

Abandoned _____

Date

10/4 191 9

Pyle

Scout

Map No. K10 Sec. 16 Twp. 29 R. 7Well No. 1 CraftBrown Ranch Oil Company

Contractor

SECTION PLAT

1120 Ft. from N. Line

Ft. from S. Line

Ft. from E. Line

200 Ft. from W. Line

0			

Location

Rig up

Drilling and Remarks:

*S. D. for
funds @
1000'*

RECORD

Cased _____ in., _____ ft.

Sand _____

Gas _____

Oil _____

Total Depth _____

PRODUCTION

1st 24 hrs. Nat. _____

1st 24 hrs. after shot _____

Gas _____ Cu. Ft.

Dry Hole _____

Abandoned _____

Date

10/19 1919

Pyle

Scout

Map No. K10 Sec. 16 Twp. 29 R. 7Well No. 1 CraftBrown Ranch OIL Company

Contractor

SECTION PLAT

1120			

1120 Ft. from N. Line

Ft. from S. Line

Ft. from E. Line

200 Ft. from W. Line

Location

Rig up

Drilling and Remarks:

RECORD

Cased in., ft.

Sand

Gas

Oil

Total Depth

PRODUCTION

1st 24 hrs. Nat.

1st 24 hrs. after shot

Gas Cu. Ft

Dry Hole 3173

Abandoned

Date

Pyle

8/25 1912

Scout