



Map No. Kaw Sec. 34 Twp. 34 R. 2E


Well No. 1 Mc Crew Farm  
Prairie City. Company.

330 Ft. from N. Line

..... Ft. from S. Line

..... Ft. from E. Line

1320 Ft. from W. Line

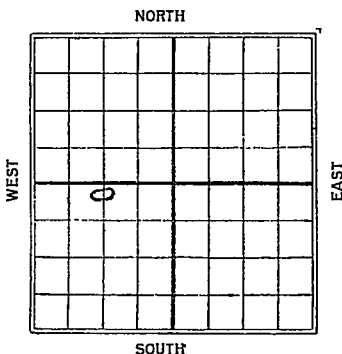

Date	REPORT
1925	
<del>6/10</del>	Location
6/5	Rig
7/22	3M Gas 820-30 S.D. 1140
7/29	1435'
8/7	sand 1545-70-12A Gas @ 1550'
8/14	T.D. 1950 S.D. gas 10"
8/19	set 10" 1950'
8/26	Zacs
9/2	8' 2046' - July 20 75
9/9	T.D. 2205 N.R. 8"
9/30	Rigging up
10/6	plug 2530
11/18	J 3448 oil 3476
	T.D. 3499 50 Bbls 1st day
	21 Bbls 2nd day
	18 Bbls 3rd day
	mfg about 2.5 Bbls water
1926	(Later ticket) Couldn't plug back successfully
	D. + G. 3499

*Summer*

Map No. KANSAS Sec. 34 Twp. 34 R. 2 E

Well No. 1 - m c crew

Pravil O. & S. Company

Contractor

**FIRST REPORT**

**SECTION PLAT**

330 Ft. from N. Line

----- Ft. from S. Line

----- Ft. from E. Line

1320 Ft. from W. Line

	○		

Location ✓✓

Rig up -----

Drilling and Remarks:

**RECORD**

Cased ----- in., ----- ft.

Sand -----

Gas -----

Oil -----

Total Depth -----

**PRODUCTION**

1st 24 hrs. Nat. -----

1st 24 hrs. after shot -----

Gas ----- Cu. Ft.

Dry Hole -----

Abandoned -----

Date

**JUNY 55 1925**

192

**M. A. BENEAR**

Scout

Map No. **KANSAS** Sec. 34 Twp. 34 R. 2E

Well No. 1 Mc Cuen

Prairie O & G Company

Contractor

**SECTION PLAT**

330 Ft. from N. Line

\_\_\_\_\_ Ft. from S. Line

\_\_\_\_\_ Ft. from E. Line

1320 Ft. from W. Line

	o		

**COMPLETED**

Location \_\_\_\_\_

Rig up \_\_\_\_\_

Drilling and Remarks:

T.S. 3448  
Oil 3476  
T.D. 3499  
50 ft 1st day.  
21 " 2nd "  
18 " 3rd "  
and making  
about 25 ft of water

Date

**RECORD**

Cased \_\_\_\_\_ in., \_\_\_\_\_ ft.

Sand \_\_\_\_\_

Gas \_\_\_\_\_

Oil \_\_\_\_\_

Total Depth \_\_\_\_\_

**PRODUCTION**

1st 24 hrs. Nat. \_\_\_\_\_

1st 24 hrs. after shot \_\_\_\_\_

Gas \_\_\_\_\_ Cu. Ft.

Dry Hole \_\_\_\_\_

Abandoned \_\_\_\_\_

NOV 18 1925

S. J. LEWIS

Scout

*Wm. M. Danner*

Map No. 111245 Sec. 34 Twp. 34 R. 2E7

Well No. 1 Mc. Owen

Prairie Oil & Gas. Company

Contractor

**ABANDONED**

SECTION PLAT

330 Ft. from N. Line  
 \_\_\_\_\_ Ft. from S. Line  
 \_\_\_\_\_ Ft. from E. Line  
1320 Ft. from W. Line

	o		

*Correction*

Location \_\_\_\_\_

Rig up \_\_\_\_\_

Drilling and Remarks:

*Could not get  
 this well plugged  
 back successfully  
 so. D & A.  
 T 3499.*

RECORD

Cased \_\_\_\_\_ in., \_\_\_\_\_ ft.  
 Sand \_\_\_\_\_  
 Gas \_\_\_\_\_  
 Oil \_\_\_\_\_  
 Total Depth \_\_\_\_\_

PRODUCTION

1st 24 hrs. Nat. \_\_\_\_\_  
 1st 24 hrs. after shot \_\_\_\_\_  
 Gas \_\_\_\_\_ Cu. Ft.  
 Dry Hole \_\_\_\_\_  
 Abandoned \_\_\_\_\_

Date

**JAN 19 1926**  
 \_\_\_\_\_ 192\_\_\_\_\_

**S. J. LEWIS**

Scout