


Butler

KANSAS

SECTION 22 TOWNSHIP 29S RANGE 7E

WELL NO. #1 Allendaugh

COMPANY Bedell & Catt

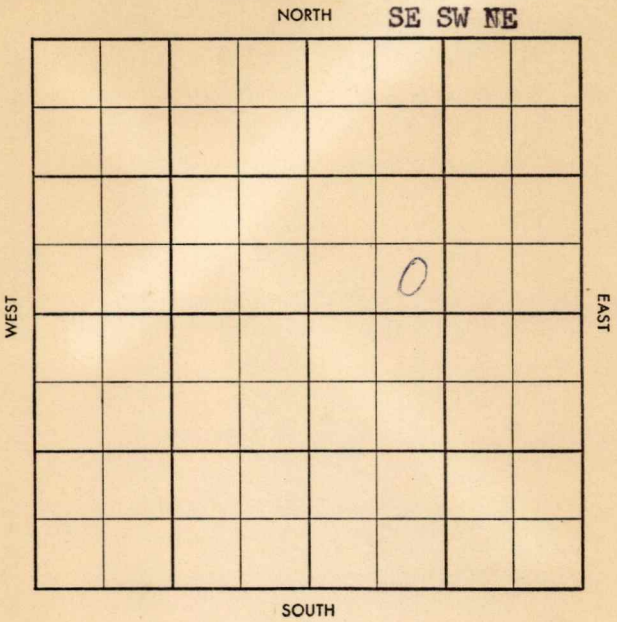

Twp. Pool.
 Co. Foot.

S-513-B

County Butler Elev. 1510 KB
 Sec. 22 Twp. 29 Rge. 7E
 Company Bedell & Catt
 Farm Name Allendaugh No. 1

TOPS	DEPTH	LOG	DATUM
Anh.			
Tp.			
H.			
Tr.			
Dg.			
B.L.			
L.			
K.C.	2135		
B.K.C.	2396		
Ce. <u>Clev</u>	2396		
C. <u>Marm</u>	2442		
M. <u>Peru</u>	2503		
M. <u>Ft Scot</u>	2519		
K. <u>ce</u>	2575		
Mz. <u>Bart 2</u>	2673		
Mq. <u>m</u>	2852		
V.			
S.			
S.			
A.			
R.			
Pf.			
G.			
T.D.	2902		

Loc. in Sec. SE SW NE
 Geol. Link
 Contr. Gearhart-Canada
 Pool Wildcat
 ABANDONED
 JUL 2 '58

Date Comm. 6-23-58 8" 137/125
 Location JUN 14 '58 JUN 18 '58 JUN 25 '58 Ø 245
JUL 2 '58 DST 2876-2902 1hr
35' socm 60 w/m 200' SW FP
30-30 BHP 945

D6A

Twp. ~~XXXXXX~~ Pool. ~~XXXXXX~~

Co. ~~XXXXXX~~ Facet. ~~XXXXXX~~

WILDCAT

S-513-B

County Butler Elev. _____
 Sec. 22 Twp. 29 Rge. 7E
 Company Bedell & Catt
 Farm Name Allendaugh No. 1

TOPS	DEPTH	LOG	DATUM
Anh.			
Tp.			
H.			
Tr.			
Dg.			
B.L.			
L.			
K.C.			
B.K.C.			
Ce.			
C.			
M.			
M.			
K.			
Mz.			
Mq.			
V.			
S.			
S.			
A.			
R.			
Pf.			
G.			
T.D.			

Loc. in Sec. _____

SE SW NE

Geol. _____

Contr. _____

Gearhart-Canada

Pool _____

Wildcat



Date Comm. _____

Location

LS

No.

Sec.

T.

R.