


Section 34 Township 34 Range 2E

Well No. 3 2 Post

Company Stelbar Oil

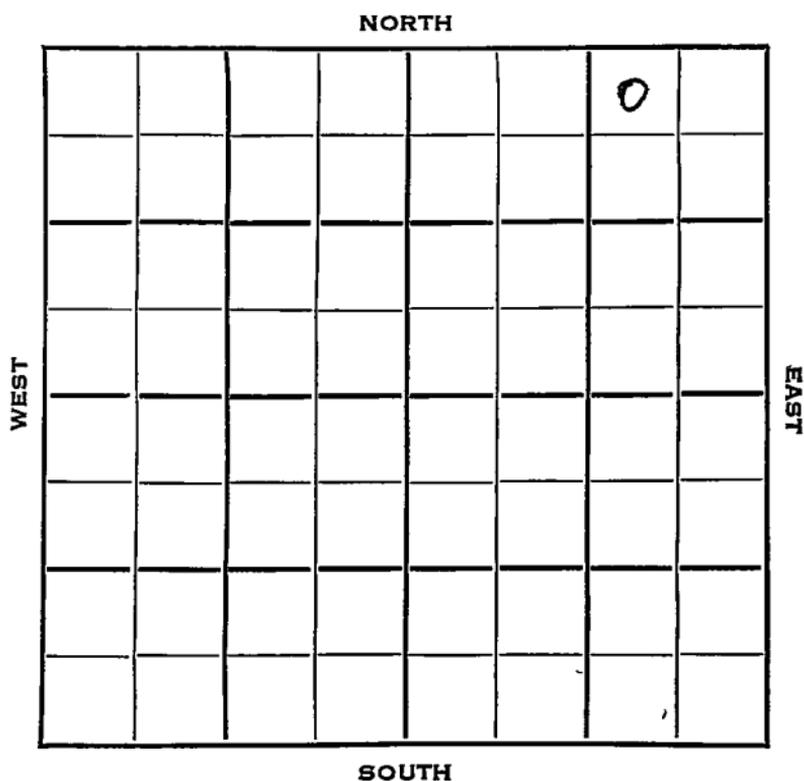

Summer

KANSAS

|            |            |          |   |
|------------|------------|----------|---|
| SEC.<br>34 | TWP.<br>34 | R.<br>2E | ✓ |
|------------|------------|----------|---|

WELL NO. #3  
~~#2~~ Post

COMPANY **Stelbar Oil**

CONTRACTOR


**Padgett Pool**

330 \_\_\_\_\_ Ft. from N. Line

\_\_\_\_\_ Ft. from S. Line

990 \_\_\_\_\_ Ft. from E. Line

\_\_\_\_\_ Ft. from W. Line

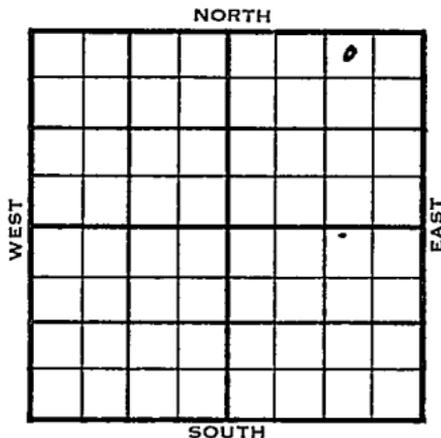

NW NE NE

|      |                    |        |
|------|--------------------|--------|
| 1953 | ELEVATION<br>1182' | REPORT |
|------|--------------------|--------|

12/30 R U R

1954  
3/31

Spud 12-30-53 D & A TD 3516  
 8" @ 126 Stal. 2355 Layton 2755'  
 KC 2960 Miss. 3428 TD 3516  
 5" @ 2790 CO 18/2759-62  
 FU 1400' fluid 12 hr. 99% wtr.  
 S/15 BOPD & wtr. F/30 BO 200 BW  
 24 hr. SI PB 2785 7/2756-68  
 wtr. D & A

**ABANDONED**



Kansas

Map No. \_\_\_\_\_ Sec. 34 Twp. 34 R. 2E

Well No. 3 Post

Stelbar Oil Company

**CORRECTION** Contractor

NW NE NE

SECTION PLAT

330 Ft. from N. Line

\_\_\_\_\_ Ft. from S. Line

990 Ft. from E. Line

\_\_\_\_\_ Ft. from W. Line

|  |  |  |   |
|--|--|--|---|
|  |  |  | 0 |
|  |  |  |   |
|  |  |  |   |
|  |  |  |   |
|  |  |  |   |

Sumner County

Location \_\_\_\_\_

Rig up \_\_\_\_\_

Drilling and Remarks:

Reported  
#2 Post

RECORD

Cased \_\_\_\_\_ in., \_\_\_\_\_ ft.

Sand \_\_\_\_\_

Gas \_\_\_\_\_

Oil \_\_\_\_\_

Total Depth \_\_\_\_\_

PRODUCTION

1st 24 hrs. Nat. \_\_\_\_\_

1st 24 hrs. after shot \_\_\_\_\_

Gas \_\_\_\_\_ Cu. Ft.

Dry Hole \_\_\_\_\_

Abandoned \_\_\_\_\_

Date

JAN 13 1954 19

J. G. McGEHEE

Scout

