


Barton

FORM 51 5M PETROL KANSAS

Section 29 Township 16 Range 13-W

Well No. #2 Harrington "A" (Harrington)

Company Black-Marshall

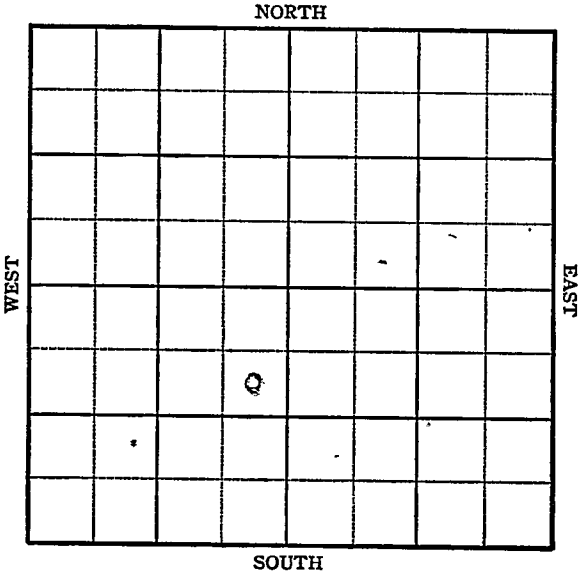

Sec. 29 Twp. 16 R. 13-W

Well No. #2 Harrington "A" Farm


Black-Marshall Company

990 Ft. from N. Line

Ft. from S. Line

330 Ft. from E. Line

Ft. from W. Line

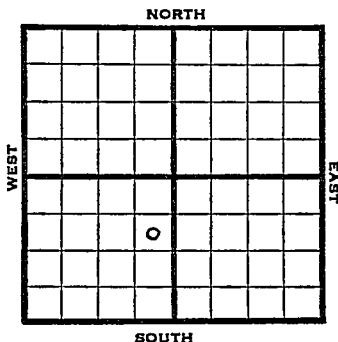

SE NE SW

1945 Elev. 1925' REPORT

12/12 Location

12/20 "

12/29 8" - 256' Drlg. 2625'

1946

1/10 Lans. 3130' Arb. 3374'

T.D. 3379' 5" - 3374'

Pump 23 oil 1 hour.

1/16

Arb. 3374'

5" @ 3374

TD 3379

Echo. Pot. 1468

Grav. 39.0

COMPLETED

KANSAS KansaPool Name SusankMap No. K-73 Sec. 29 Twp. 16 R. 13WWell No. 2 Harrington "A"Black-Marshall CompanyFIRST REPORT Contractor

SE NE SW

SECTION PLAT

990 Ft. from N. Line Ft. from S. Line330 Ft. from E. Line Ft. from W. Line

		o	

Barton CountyLocation xRig up

Drilling and Remarks:

RECORD

Cased in, ft.Sand Gas Oil Total Depth

PRODUCTION

1st 24 hrs. Nat. 1st 24 hrs. after shot Gas Cu. Ft.Dry Hole Abandoned

Date

DEC 12 1945 19S. J. LEWIS Scout

KANSAS

Kansas

Pool Name Susank

Map No. 23 Sec. 29 Twp. 16 R. 13W

Well No. 2 Harrington "A"

Black-Marshall Company

COMPLETED

Contractor

E. J. 1925

SE NE SW

SECTION PLAT

990 Ft. from N. Line

 Ft. from S. Line

330 Ft. from E. Line

 Ft. from W. Line

Barton County

Location

Rig up

Drilling and Remarks:

Per 8874
5" @ 8874
Ecl 1468
390 G

RECORD

Cased in., ft.

Sand

Gas

Oil

Total Depth 3379

PRODUCTION

1st 24 hrs. Nat.

1st 24 hrs. after shot

Gas Cu. Ft.

Dry Hole

Abandoned

Date

JAN 16 1946 19

S. J. LEWIS

Scout