

Section 29 Township 16 Range 13WWell No. #7 Harrington (A)Company Northern Ordance

NORTH

			0				

WEST

EAST

SOUTH

Barton

KANSAS

Sec. 29 Twp. 16 R. 13W

Well No. #7 Harrington (A) Farm

Northern Ordnance Company

Contractor


330' Ft. from N. Line

_____ Ft. from S. Line

330' Ft. from E. Line

_____ Ft. from W. Line

NE NE SW

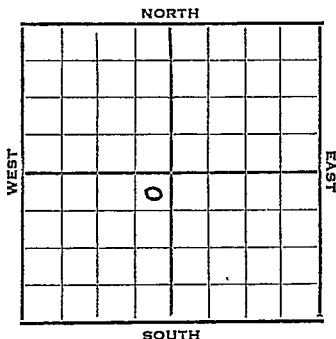

1951 Elev. 1926' REPORT

12/19 Spud 12-13-51
8" @ 274
Drlg. 1808'

1952
1/2 Spud 12-13-51
D&A TD 3405
8" @ 274
Heeb. 3061
Ians. 3139
TD 3405
D&A

Dodge 3070
Arb. 3392

ABANDONED

County Barton State KansasSec. 29 (Blk.
Twp.) 16 (Sur.
Rge.) 13W Map No.Operator Northern OrdnanceWell No. 7 Farm Harrington (A)Elev. Location NE NE SW330 Ft. From N Line SW330 Ft. From E Line Quarter1st. Report DEC 1 9 1951

Completion


Remarks

Ferrell - Contr.Spudding Date 12-13-51

Drig. Data

8" @ 274 Drig. 1808J. E. TYRA

County Barton State Kansas
 Sec. 29 (Blk. Twp.) 16 (Sur. Rge.) 13W Map No.
 Operator Northern Ordnance
 Well No. 7 Farm Harrington "A"
 Elev. 1926 Location NE NE SW

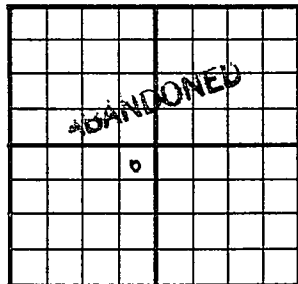

330 Ft. From N Line SW
330 Ft. From E Line Quarter
 1st. Report
 Completion JAN 2 1952
 Remarks
Ferrell Drlg. - Contr.
 Spudding Date 12-13-51

Drlg. Data D & A TD 3405
8" @ 274 Heeb. 3061 Dodge 3070
Lans. 3139 Arb. 3392 TD 3405
D & A

J. E. TYRA