


Section 29 Township 16 Range 13-W

Well No. #1 J. L. Redetzke "A"

Company Continental

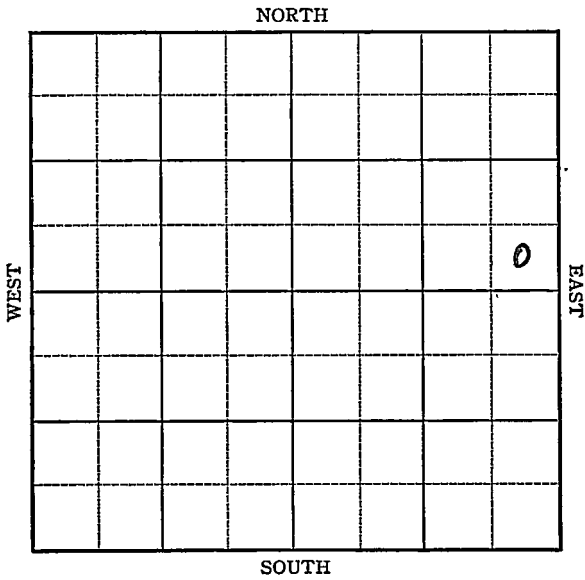

Sec. 29 Twp. 16 R. 13-W

Well No. #1 J. L. Redetzke "A" Farm

Continental Company

(Trapp)


_____ Ft. from N. Line

330 Ft. from S. Line

330 Ft. from E. Line

_____ Ft. from W. Line

Elev. 1933

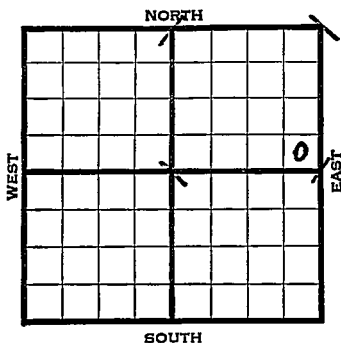

1941	REPORT
9/24	Derrick.
10/2	10" - 367' Drlg. 1587'
10/9	Drlg. 3164'
10/16	Arb. 3381-84' T.D. 6" - 3382'
	RUST.
10/23	T.D. 3392' 1750' oil.
10/30	" " " "
11/6	" " " "
11/13	" " " "
11/19	Arb. 3381'
	6" - 3382'
	T.D. 3392'
	2000 acid.
	Potential 271 bbls., pump.
	39. Gravity
	COMPLETED

Barton

KANSAS

Map No. K-93 Sec. 29 Twp. 16 R. 13WWell No. 1 J. L. Redetzke "A"Continental CompanyCOMPLETED Contractor

SE NE

SECTION PLAT

 Ft. from N. Line330 Ft. from S. Line330 Ft. from E. Line Ft. from W. Line

			o

TRAPP POOL

Location Rig up Drilling and Remarks: CR 83381 !6 " @ 33822000 acrilPump 271 P.S.39° SW

RECORD

Cased in., ft.Sand Gas Oil Total Depth 3392

PRODUCTION

1st 24 hrs. Nat. 1st 24 hrs. after shot Gas " " Cu. Ft.Dry Hole Abandoned Date

NOV 19 1941

19

S. J. LEWIS

Scout