

Saline

FORM 51


KANSAS

Section 7 Township 16 Range 3W

Well No. #2 Anderson - Grothaus (A)

Company National Associated Pet.

NORTH

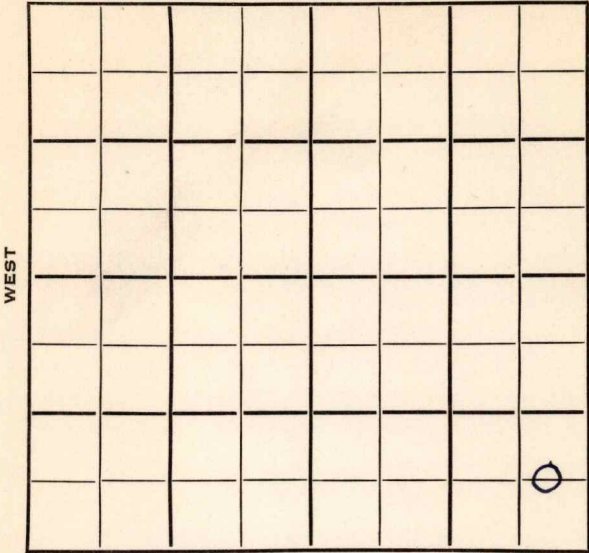

WEST

EAST

SOUTH

Saline **KANSAS**

Sec. 7 Twp. 16 R. 3W

Well No. #2 Anderson-Grothaus "A" Farm

National Associated Petr. Company

National Assoc. Contractor
Smolan

Ft. from N. Line

660


Ft. from S. Line

330

Ft. from E. Line

Ft. from W. Line

C E/2 SE SE

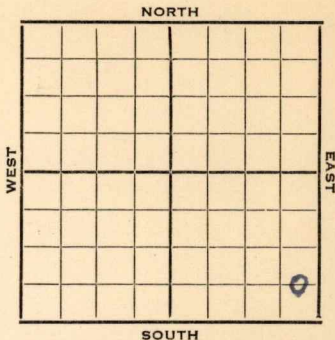

1953 **Elev. 1400'** REPORT

7/8 Spud 7-3-53
10" @ 145'
1" sg. @ 530'

7/22 **Miss 2967, KH 3244, Mq dol 3480**
RTD 3482
5" @ 3481

7/29 CO 3482, 500A, 10 go + 1 bwph
DD @ 3495

8/5 Spud 7-3-53
D&A
TD 3500'
10" @ 145'
Miss 2967, Kh. 3244, Maq. 3480
TD 3482
5" @ 3481,
CO to 3482, 500A, 10 go 1 bwph
DD 3495, DD 3500
D&A

ABANDONED

County Saline State Kansas

Sec. 7 (Blk. 16) (Sur. 3W) (Twp. 16) (Rge. 3W) Map No.

Operator National Associated Pet.

Well No. 2 Farm Anderson -Grothaus (A)

Elev. _____ Location C E/2 SE SE

FIRST REPORT

660 Ft. From S Line SE

330 Ft. From E Line Quarter

Ist. Report JUL 8 1953

Completion _____

Remarks _____

National Assoc. - Contr.

Spudding Date 7-3-53

Drlg. Data Smolan

10" @ 145 Tsg @ 530

J. G. McGEHEE


County Saline State Kansas

Sec. 7 (Blk. 16) (Sur. 3W) (Twp. 16) (Rge. 3W) Map No.

Operator National Assoc. Pet.

Well No. 2 Farm Anderson-Grothaus

Elev. 1400 Location C E L S E S E

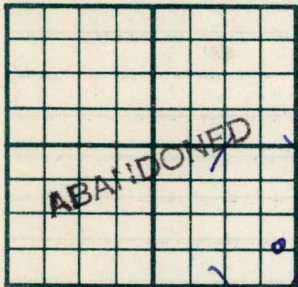

660 Ft. From S Line SE

330 Ft. From E Line Quarter

1st. Report

Completion Aug 5 1953

Remarks Smolan Pool

Nat'l Assoc. - Contr.

Spudding Date 7-3-53

Drlg. Data D & A TD 3500

10" @ 145 Miss. 2967 Kh. 3244

Mag. 3480 TD 3482 5" @ 3481 CO to 3482

500 A 10 go 1 bwph DD 3495 DD 3500

D & A