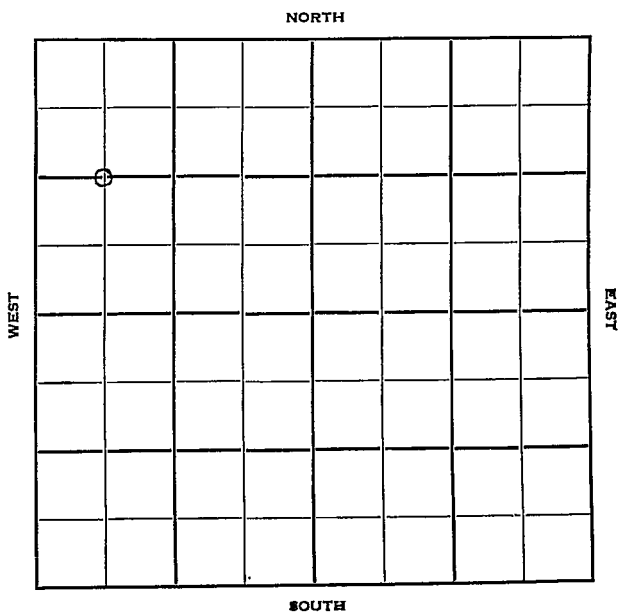


Section 29 Township 16 Range 13-WWell No. #1 StoskopfCompany Murfin & Vernon Oil & Gas

KANSAS

Barton

Sec. 29 Twp. 16 R. 13-W

Well No. #1 Stoskopf Farm

Murfin & Vernon Oil & Gas Company

Contractor


1320 Ft. from N. Line

Ft. from S. Line

Ft. from E. Line

660 Ft. from W. Line

C $W\frac{1}{2}$ NW

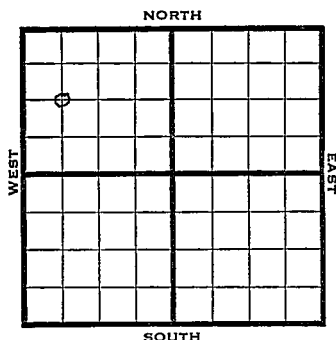

1950 Elev 1932 REPORT

7/12 Spud 7-10-50
Drlg

8/23 8" @ 168

Anhy 875

TD 3388

500 A

S/2 boph

Comp 189 bopd 2% wtr

Completed

COMPLETED

Kansas

Map No. _____ Sec. 29 Twp. 16 R. 13WWell No. 1 StoskonfMurfin & Vernon Oil & Gas Company_____
ContractorC $W\frac{1}{2}$ NW


E 1. 1932

SECTION FLAT

1320 Ft. from N. Line

_____ Ft. from S. Line

_____ Ft. from E. Line

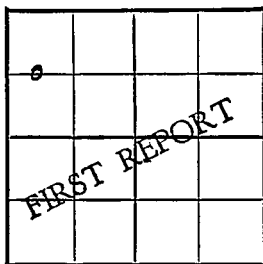660 Ft. from W. Line

Barton County

Location _____

Rig up _____

Drilling and Remarks:

Spud 7-10-50

drlg.

RECORD

Cased _____ in., _____ ft.

Sand _____

Gas _____

Oil _____

Total Depth _____

PRODUCTION

1st 24 hrs. Nat. _____

1st 24 hrs. after shot _____


Gas _____ Cu. Ft.

Dry Hole _____

Abandoned _____

Date

JUL 12 1950 19 J. E. TYRA Scout

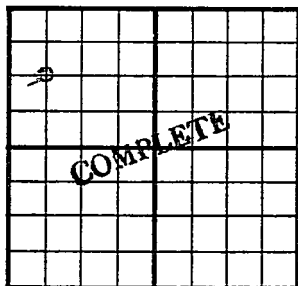County Barton State KansasSec. 29 (Blk.) 16 (Sur.) 13W Map No. 3Operator Murfin & Vernon Oil & GasWell No. 1 Farm StoskopfElev. 1932 Location C W $\frac{1}{2}$ NW1320 Ft. From N Line NW660 Ft. From W Line Quarter1st. Report Completion AUG 23 1950Remarks Spudding Date 7-10-50Drlg. Data Oil well TD 33888" @ 168 Anhy 875 TD 3388 500 AS/ 2 bopd Comp. 189 bopd 2% water

J. E. TYRA