

KANSAS

Barton

FORM 51 5M 10-41 PETROL

Section 29 Township 16 Range 13-W

Well No. #2 Stoskopf

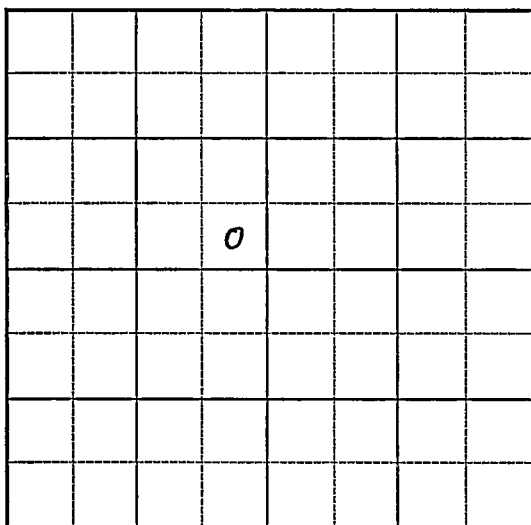
Company R. Olsen-Anderson & Pritchard

Trapp Pool

NORTH

WEST

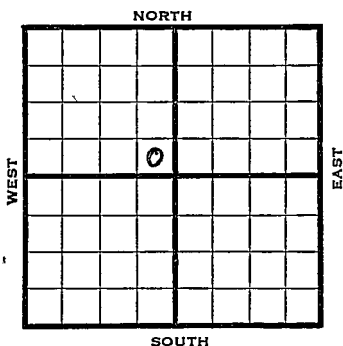
EAST



SOUTH

Sec. 29 Twp. 16 R. 13-WWell No. #2 Stoskopf FarmR. Olsen-Anderson & Pritchard Company

(Trapp)

 Ft. from N. Line330 Ft. from S. Line330 Ft. from E. Line Ft. from W. Line

Elev. 1933

1942

REPORT

1942	REPORT
7/1	Location
7/8	8" - 200' WOC.
7/15	" " "
7/22	" " "
7/29	" " "
8/5	" " "
8/12	Drig 860
8/19	Drig. 2960'
8/27	Arb 3384 SSO 3387-89 TD 5" @ 3386 Rust.
9/2	" " "
9/9	" " "
9/16	TD 3391-2160 acid swb oil per hr
9/23	pump 45 oil 24 hrs sw
9/30	TD 3391
10/7	5 qts. 3387-91 C.O.
10/14	Arb. 3384 5" - 3386 4600 acid Pump 12 oil plus 4 W.Pot. Gravity 39. T.D. 3391

COMPLETED

Barton

KANSAS

Map No. 23 Sec. 29 Twp. 16 R. 13WWell No. 2 StoskopfR. Olsen-Anderson & Company
Pritchard**FIRST REPORT** Contractor

SE NW

SECTION PLAT

 Ft. from N. Line330 Ft. from S. Line330 Ft. from E. Line Ft. from W. Line

Trapp Pool

RECORD

Location XXXCased in., ft.Rig up Sand

Drilling and Remarks:

Gas Oil Total Depth

PRODUCTION

1st 24 hrs. Nat. 1st 24 hrs. after shot Gas Cu. Ft.Dry Hole Abandoned

Date

JUL 1 1942
19S. J. LEWIS

Scout

Barton

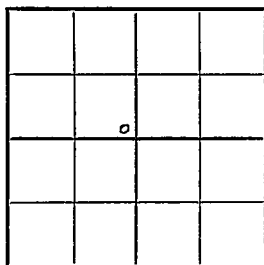
KANSAS

Map No. 73 Sec. 29 Twp. 16 R. 13WWell No. 2 StoskopfR. Olsen-Anderson & CompanyCOMPLETED Pritchard

Contractor

SE NW

SECTION PLAT.

 Ft. from N. Line330 Ft. from S. Line330 Ft. from E. Line Ft. from W. Line

TRAPP POOL

Location Rig up

Drilling and Remarks:

*CR 83384**5" @ 3386**#600 Acid**Pump 12 oil + 4W.**P.S.**39° SW*

RECORD

Cased in., ft.Sand Gas Oil Total Depth CR 83384

PRODUCTION

1st 24 hrs. Nat. 1st 24 hrs. after shot Gas Cu. Ft.Dry Hole * Abandoned

Date

OCT 14 1942

19

S. J. LEWIS Scout