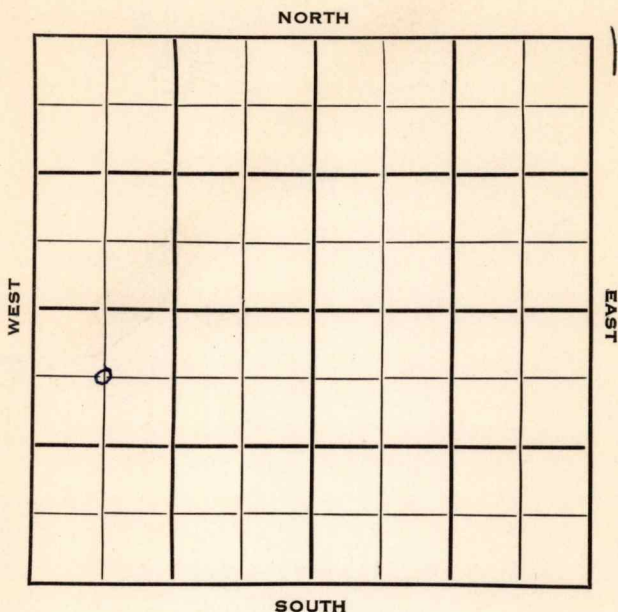


Saline

KANSAS


Section 8 Township 16 Range 3WWell No. #1 OlsonCompany National Assoc. Petroleum

Saline

KANSAS

Sec. 8 Twp. 16 R. 3 WWell No. # 1 Olson FarmNational Assoc. Pet. CompanyExploration Drlg. Contractor660 Ft. from N. Line Ft. from S. Line Ft. from E. Line660 Ft. from W. Line

C NW SW

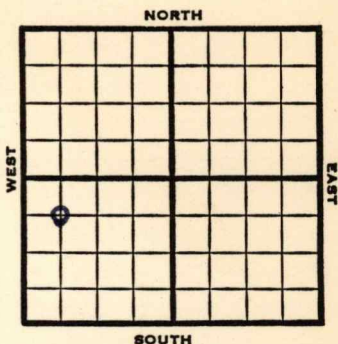

1953

Elev. 1360' REPORT

2/25

Spud 2-22-53
10" @ 164

3/12

Lans. 2277' Miss 2916' KH 3206'
Mq sha 3427' Mq Dol 3440'
TD 3444' 5" @ 3441'

3/19

CO 3444' 50 A FU 1800' oil 10 hrs.

3/26


1000A, S/7 BOPH 10 hrs.,
P/98 BO 16 hrs., P/133 BO 24 hr

4/1

Spud 2-22-53
Oil Well
TD 3444'
10" @ 164Lans 2277', Miss 2916', Kh 3206, Maq.
sh. 3427, Maq dol. 3440,TD 3444'
5" @ 3441'CO to 3444 50 A FU 1800' oil
10 hr. 1000 A S/ 7 boph 10 hr. P/
98 bo 16 hr. P/ 133 bo 24 hr.
Comp. 199 bopd 2% wtr.

COMPLETED

County Saline State Kansas
 Sec. 8 (Blk.) 16 (Sur.) 3W Map No.
 Operator National Assoc. Pet.
 Well No. 1 Farm Olson
 Elev. _____ Location C NW SW

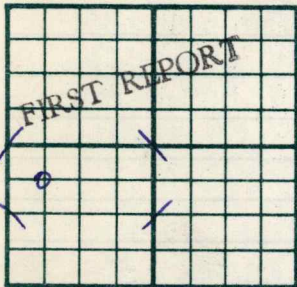


660 Ft. From N Line SW
660 Ft. From W Line Quarter
 1st. Report FEB 25 1953
 Completion _____
 Remarks _____
Exploration Drlg. - Contr.
 Spudding Date 2-22-53

Drlg. Data

10" @ 164

J. G. McGEHEE

County Saline State Kansas
 Sec. 8 (Blk.) 16 (Sur.) 3W Map No.
 Operator National Assoc. Pet.
 Well No. 1 Farm Olson
 Elev. 1360 Location C NW SW

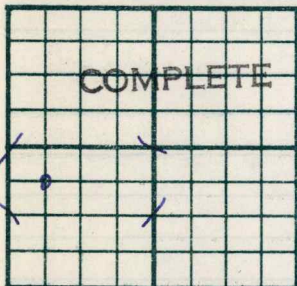

660 Ft. From N Line SW
660 Ft. From W Line Quarter

1st. Report

Completion APR 1 1953

Remarks

Exploration Drlg. - Contr.

Spudding Date 2-22-53

Drlg. Data Oil well TD 3444
10" @ 164 Lans. 2277 Miss. 2916
Kh. 3206 Maq. sh. 3427 Maq. dol. 3440
TD 3444 5" @ 3441 CO to 3444 50 A
FU 1800' oil 10 hr. 1000 A S/ 7 boph
10 hr. P/ 98 bo 16 hr. P/ 133 bo 24 hr
Comp. 199 bopd 2% wtr.