


Section 8 Township 16 Range 3W

Well No. #1 Lindholm

Company Jones, Shelburne & Farmer

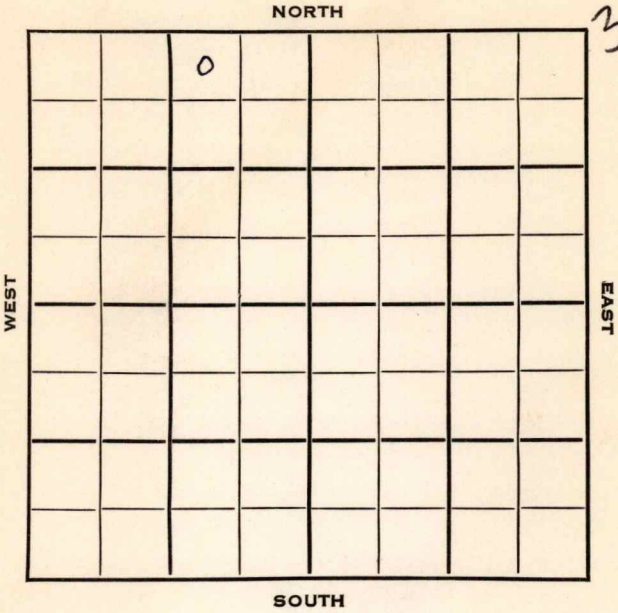

Sec. 8 Twp. 16 R. 3 W

Well No. # 1 Lindholm Farm

Jones, Shelburne & Farmer Company

Shields Contractor


330 Ft. from N. Line

_____ Ft. from S. Line

990 Ft. from E. Line

_____ Ft. from W. Line

NW NE NW

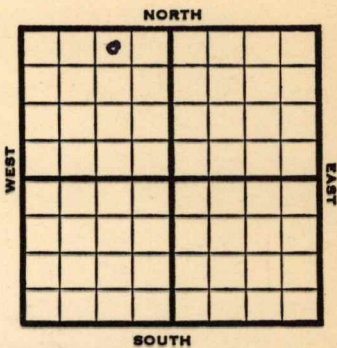

1953

Elev. 1344'

REPORT

2/11

Spud 2-8-53
8" @ 358

Drlg. 541

2/19

Drlg. 3103'

2/26

**Miss 2892, B Miss 3191, KH
3230, Mq shale 3344, Mq Dol
3410,**

RTD 3412

DD 3413 TD

S/35 goph, 500A

3/12

S/5 BOPH 2 hrs. POP

3/19

NR

3/25

Spud 2-8-53

Oil Well

TD 3413

8" @ 358

**Miss 2892, B. Miss 3191, Kh
3230, Maq. sh. 3344, Maq dol
3410**

TD 3412,

5" @ 3410

DD 3413, S/35 goph, 500A

S/5 boph 2 hrs.

DST 3405-12, opn 1 hr., rec.

310' oil

Comp. 124 bopd 1% wtr.

COMPLETED

County Saline State Kansas

Sec. 8 (Blk. 16) (Sur. Rge.) 3W Map No.

Operator Jones, Shelburne & Farmer

Well No. 1 Farm Lindholm

Elev. 1344 Location NW NE NW

330 Ft. From N Line NW
 990 Ft. From E Line Quarter

1st. Report

Completion MAR 25 1953

Remarks

Shields - Contr.

Spudding Date 2-8-53

Drlg. Data Oil well TD 3413

8" @ 358 Miss. 2892 B. Miss. 3191

Kh. 3230 Maq. sh. 3344 Maq. dol. 3410

TD 3412 5" @ 3410 DD 3413 S/ 35 goph

500 A S/ 5 boph 2 hr. DST 3405-12

open 1 hr. Rec. 310' oil

Comp. 124 bopd 1% wtr.

