


Section 8 Township 16 Range 3 W

Well No. # 2 Lindholm

Company Jones, Shelburne & Farmer

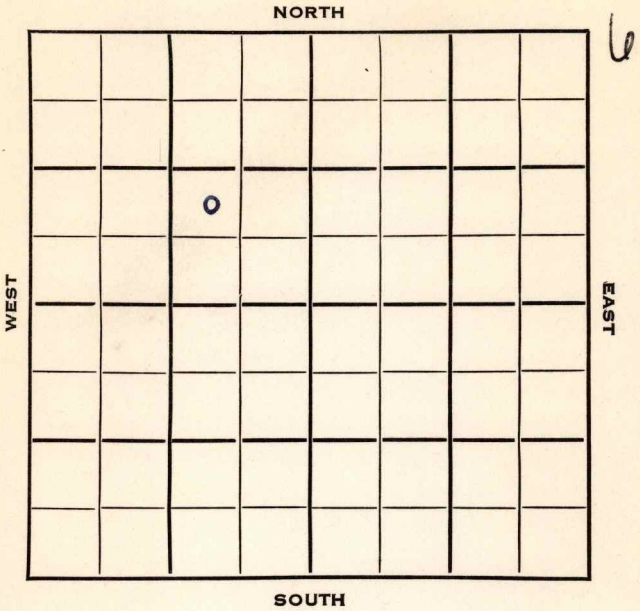

Saline **KANSAS**




Sec. 8 Twp. 16 R. 3W

Well No. #2 Lindholm Farm

Jones, Shelburne & Farmer Company

Shields Contractor
Salemborg Pool

 Ft. from N. Line
990 Ft. from S. Line
990 Ft. from E. Line
 Ft. from W. Line
NW SE NW

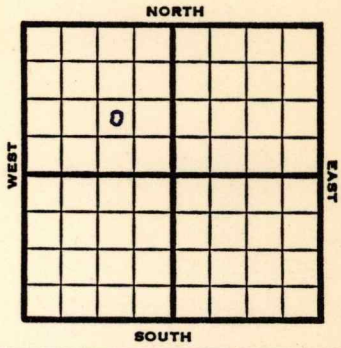

1953 **Elev. 1335'** REPORT

5/13 Spud 5-8-53
8" @ 353
Drlg. 2070'

5/21 TD 3402 5" @ 3400

5/28 **Miss 2905, Kh 3167, Mg Dol 3397,**
DD 3404 TD 500 A S/6 boph

6/3 N.R.

6/24 NR

7/1 "

7/8 NR

7/22 "

7/29 "

8/5 Spud 5-8-53
Oil Well
TD 3404
8" @ 353

Miss 2905, Kh. 3167, Maq. 3397
TD 3404, 500A, S/6 boph
Comp. 144 bopd

COMPLETED

