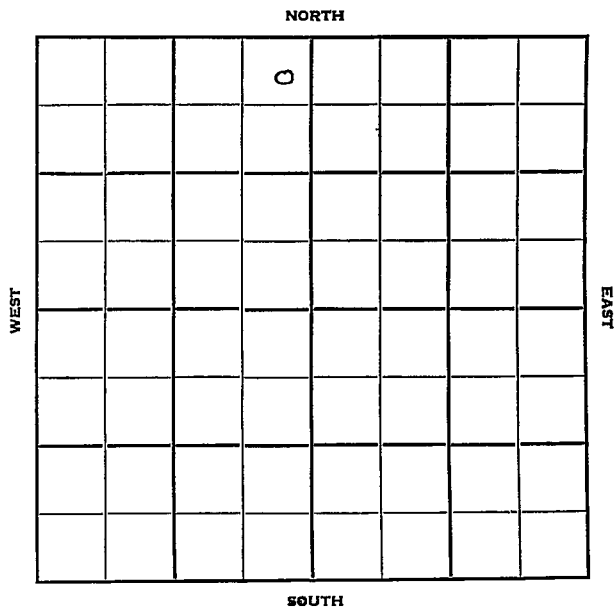


Section 31 Township 16 Range 13WWell No. #1 RudeCompany Nadel & Gussman

Barton KANSAS

Sec. 31 Twp. 16 R. 13 W

Well No. # 1 Rude Farm

Nadel & Gussman Company

Reserve Contractor

Semi-Wildcat


330 Ft. from N. Line

 Ft. from S. Line

330 Ft. from E. Line

 Ft. from W. Line


NE NE NW

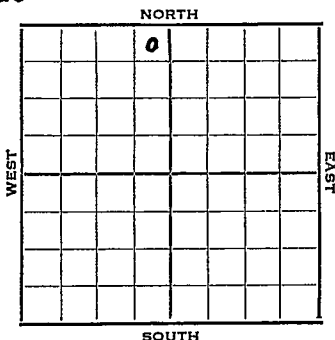

1952 Elev. 1964' REPORT

4/9 Spud 4-4-52
8" @ 225'
Drlg. 1798'

4/16 Spud 4-4-52
D & A TD 3480' 8" @ 225'
Heeb 3138' Lans. 3216'
Cong. 3444-80' TD
D & A
ABANDONED

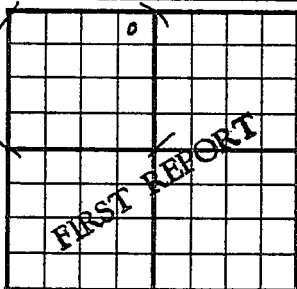County **Barton** State **Kansas**Sec. **31** (Blk.) **16** (Sur.) **13W** Map No.Operator **Nadel & Gussman**Well No. **1** Farm **Rude**Elev. Location **NE NE NW****330** Ft. From **N** Line **NW****330** Ft. From **E** Line Quarter1st. Report **APH 9 1952**

Completion

Remarks


Reserve - Contr.Spudding Date **4-4-52**Drlg. Data **Semi Wildcat****8" @ 225 Drlg. 1798****J. G. McGEHEE**

County Barton State Kansas
 Sec. 31 (Blk. 16) (Sur. Rge.) 13W Map No.

Operator Nadel & Gussman

Well No. 1 Farm Rude

Elev. 1964 Location NE NE NW

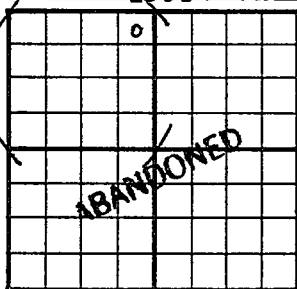

330 Ft. From N Line NW

330 Ft. From E Line Quarter

1st. Report

Completion APR 16 1952

Remarks Semi Wildcat
Reserve Drlg. - Contr.

Spudding Date 4-4-52

Drlg. Data D & A TD 3480

8" @ 225 Heeb. 3138 Lans. 3216

Cong. 3444-80 TD

D & A

J. G. McGEHEE