


KANSAS Barton County

Section 31 Township 16 Range 13W

Well No. #1 Susank

Company Threeway Drlg. et al

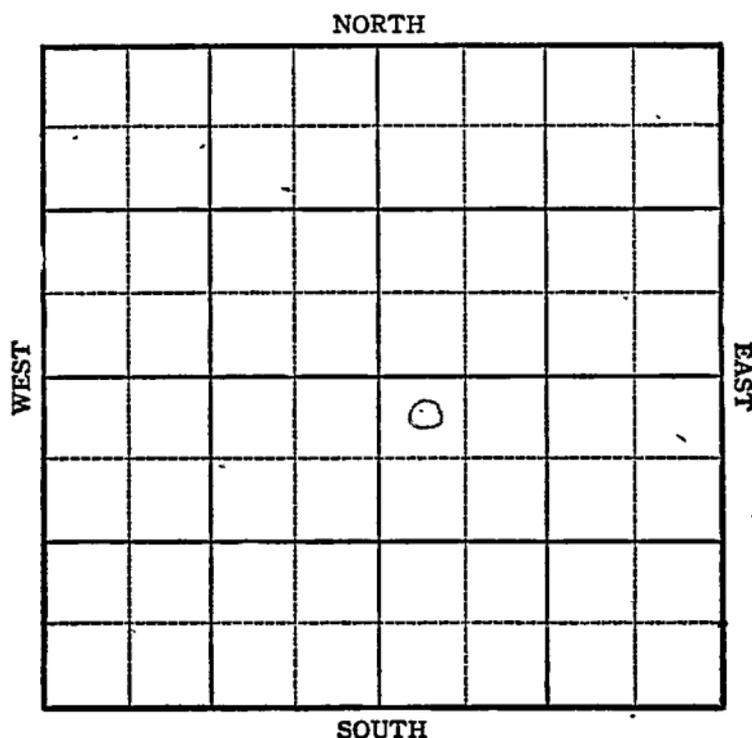

Sec. 31 Twp. 16R. 13W

Well No. #1 Susank Farm


Treeway Drlg. et al Company
Ainsworth

330 Ft. from N. Line

_____ Ft. from S. Line

_____ Ft. from E. Line

330 Ft. from W. Line

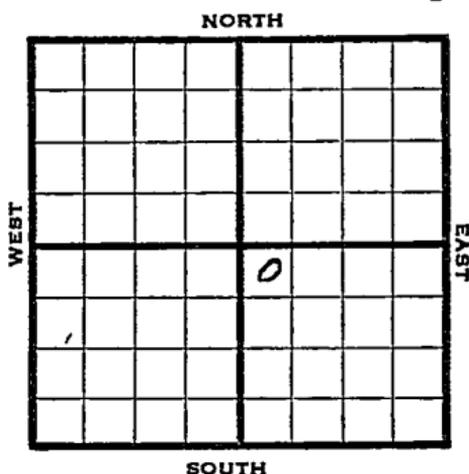

NW SE

1944

R E P O R T

11/15 Location

11/24 8" @ 194 Anhy 951 Drlg. 1775

11/29 Drlg. 2730


12/6
Lans 3210
Cong 3438
TD 3491
3491 in Cong

ABANDONED

Pool Name AinsworthMap No. 73 Sec. 31 Twp. 16 R. 13WWell No. 1 SusankThreeway Drig. etal CompanyFIRST REPORT Contractor

NW SE

SECTION PLAT

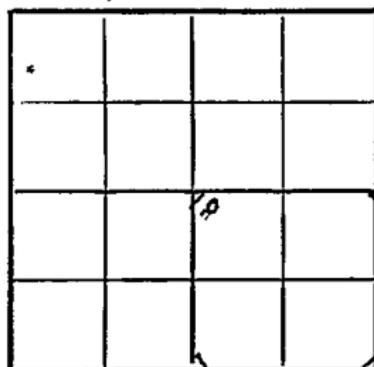330 Ft. from N. Line

Ft. from S. Line

Ft. from E. Line

330 Ft. from W. LineBar tonLocation X

Rig up _____

Drilling and Remarks:

Hot gas

RECORD

Cased _____ in., _____ ft.

Sand _____

Gas _____

Oil _____

Total Depth _____

PRODUCTION

1st 24 hrs. Nat. _____

1st 24 hrs. after shot _____

Gas _____ Cu. Ft.

Dry Hole _____

Abandoned _____

Date

NOV 15 1944

19

S. J. LEWIS Scout

Pool Name AinsworthMap No. 73 Sec. 31 Twp. 16 R. 13WWell No. 1 SusankThreeway Dr^l. _____ Company _____

ABANDONED

Contractor _____

NW SE

SECTION PLAT

		o	

330 Ft. from N. Line

_____ Ft. from S. Line

_____ Ft. from E. Line

330 Ft. from W. LineBarton

Location _____

Rig up _____

Drilling and Remarks:

Lease 8210Lease 84353491 in Cong

RECORD

Cased _____ in., _____ ft.

Sand _____

Gas _____

Oil _____

Total Depth 3491

PRODUCTION

1st 24 hrs. Nat. _____

1st 24 hrs. after shot _____

Gas _____ Cu. Ft.

Dry Hole _____

Abandoned _____

Date

DEC 6 1944 19S. J. LEWIS Scout