


Section 34 Township 13 Range 17W

Well No. #1 Braun

Company Elreco

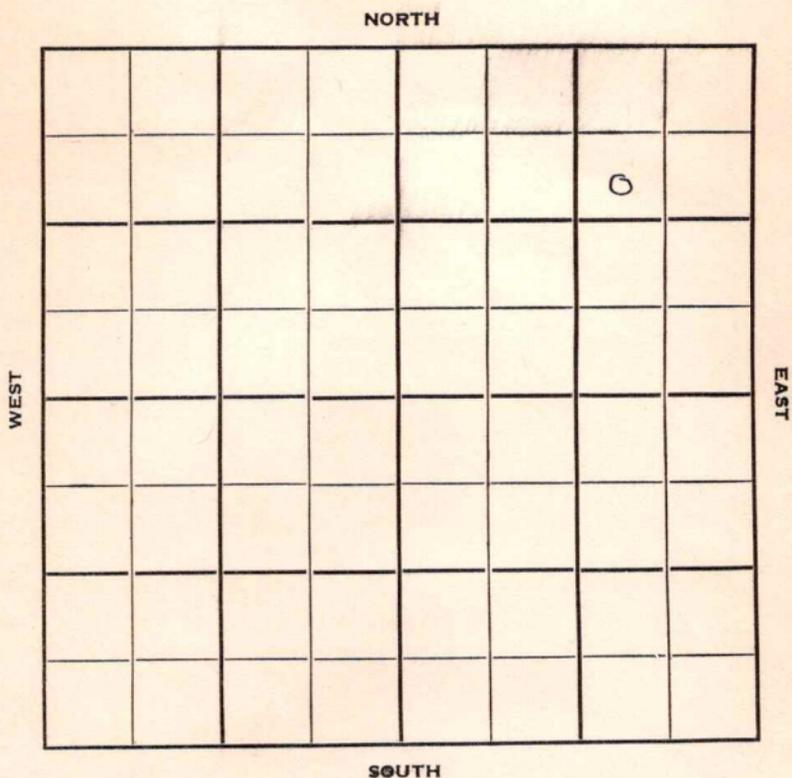

Ellis

KANSAS 17W

Sec. 34 Twp. 13 R. 17W

Well No. #1 Braun Farm

Elreco Company

Anschutz Drlg. -Contr. Contractor

Wildcat


990' Ft. from N. Line

_____ Ft. from S. Line

990' Ft. from E. Line

_____ Ft. from W. Line

SW NE NE

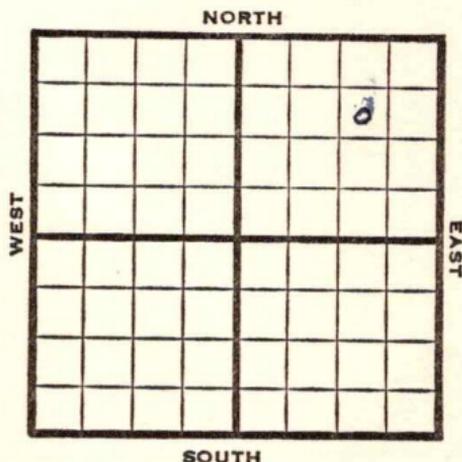

1951 **Elev. 1975** REPORT

9/6 Spud 9-2-51
8" @ 290
WOC

10/24 Spud 9-2-51
Oil Well TD 3494
8" @ 290
Anhy 1148 Lans. 3237
DST 3238-68 open 45 min. rec.
240' fld. 60' oil & GCM
180' GCM
DST 3288-3310 open 1/2 hr.
Rec. 125' ho & GCM 180' mud
& oil
DST 3326-34 open 1 hr. rec. 30' OCM
DST 3365-77 open 1 hr. Rec. 90'
HO&GCM 50% oil
DST 3409-25 open 1 hr. Rec. 22"
O&GCM **Arb. 3478** TD 3482
5" φ 3480 DD 3486 B/ 2 BOPH
S/ 55 BO 22 hr. 500 A w¹/₂ BOPH
DD 3494 S/ 6 BOPH 1000 A
S/ 7 BOPH 7 hr.
Comp. 228 BOPD

COMPLETED

County **Ellis** State **Kansas**

Sec. **34** (Blk. **13** (Sur. Rge.) **17W** Map No.

Operator **Elreco**

Well No. **1** Farm **Braun**

Elev. Location **SW NE NE**

990 Ft. From **N** Line **NE**

990 Ft. From **E** Line Quarter

1st. Report **SEP 5 1951**

Completion

Remarks

Anschutz Drlg. - Contr.

Spudding Date **9-2-51**

FIRST REPORT

Drlg. Data **Wildcat**

8" @ 290 WOC

J. E. TYRA

County Ellis State Kansas

Sec. 34 (Blk. 13) (Sur. Rge.) 17W Map No.

Operator Elreco

Well No. 1 Farm Braun

Elev. 1975 Location SW NE NE

990Ft. From N Line NE

990Ft. From E Line Quarter

Ist. Report

Completion OCT 24 1951

Remarks Wildcat

Anschutz Drlg. - Contr.

Spudding Date 9-2-51

Drlg. Data Oil well TD 3494

8" @ 290 Anhy 1148 Lans. 3237

DST 3238-68 open 45 min. Rec. 240' fld.

60' oil & gcm 180' gcm DST 3288-3310

open 1/2 hr. Rec. 125' ho & gcm 180' mud

& oil DST 3326-34 open 1 hr. Rec. 30'

oem DST 3365-77 open 1 hr. Rec. 90'

ho & gcm 50% oil DST 3409-25 open 1 hr

Rec. 22' oil & gcm Arb. 3478 TD 3482

5" @ 3480 DD 3486 B/ 2 boph S/ 55 bo

22 hr. 500 A 2 1/2 boph DD 3494

S/ 6 boph 1000 A S/ 7 boph 7 hr.

Comp. 228 bopd

J. E. TYRA