

Section 8 Township 16 Range 3 W

Well No. # 2 H. T. Johnson "B"

Company Phillips & Sanderson

NORTH

4

WEST

	0						

EAST

SOUTH

Sec. 8 Twp. _____ R. _____

Well No. #2 H. T. Johnson "B" Farm _____

Phillips & Sanderson Company _____

Salemburg Pool Contractor _____


330 Ft. from N. Line

_____ Ft. from S. Line

_____ Ft. from E. Line

990 Ft. from W. Line

NE NW NW

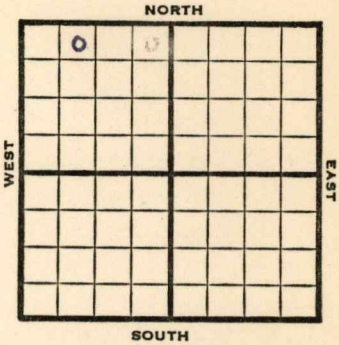

1953 **Elev. 1342'** REPORT

- 5/20 Location
- 5/28 13" @ 149'
8" @ 350'
- 6/3 Drlg 2100'
- 6/10 Drlg 3084'
- 6/24 **Mq 3417'** RTD 3420 5" @ 3418
- 7/1 N.R.
- 7/8 CO 3420 TD
1500 A
S/38 $\frac{1}{2}$ BO 5 hrs.
FU 100' AW & 1600' oil 12 hrs.
- 7/15 NR
- 7/29 "
- 8/5 "
- 8/12 "
- 8/19 "
- 8/26 "
- 9/2 1000 A
- 9/9 N.R.

OVER

1953
9/16

Spud 5-21-53

Oil Well

TD 3420'

13" @ 149

8" @ 350

Miss 2888, Maq 3417

TD 3420

5" @ 3418

CO to 3420, 1500A

S/38 bo 5 hrs.

FU 100' acid wtr., 1600' oil 12hrs.

1000A

Comp. 120 bopd

COMPLETED

County **Saline** State **Kansas**

Sec. **8** (Blk.) **16** (Sur.) **3W** Map No.

Operator **Phillips & Sanderson**

Well No. **2** Farm **H. T. Johnson "B"**

Elev. Location **NE NW NW**

0							

330 Ft. From **N** Line **NW**

990 Ft. From **W** Line **Quarter**

1st. Report **MAY 20 1953**

Completion

Remarks

Spudding Date

Drig. Data **Salemburg Pool**

Location

FIRST REPORT

County Saline State Kansas

Sec. 8 (Blk. 16) (Sur. 3W) Map No.

Operator Phillips & Sanderson

Well No. 2 Farm H. T. Johnson "B"

Elev. 1342 Location NE NW NW

•					
COMPLETE					

330 Ft. From N Line NW

990 Ft. From W Line Quarter

Ist. Report

Completion SEP 16 1953

Remarks Salemburg Pool

Spudding Date 5-21-53

Drlg. Data Oil well TD 3420

13" @ 149 8" @ 350 Miss. 2888

Maq. 3417 TD 3420 5" @ 3418

CO to 3420 1500 A S/ 38 bo 5 hr.

FU 100' acid wtr. 1600' oil 12 hr.

1000 A Comp. 120 bopd