

KANSAS


FORM 51 5M 1-42 PETROL

Barton

Section 30 Township 16 Range 13-W

Well No. #1 Peach "B"

Company Armer & Vermon

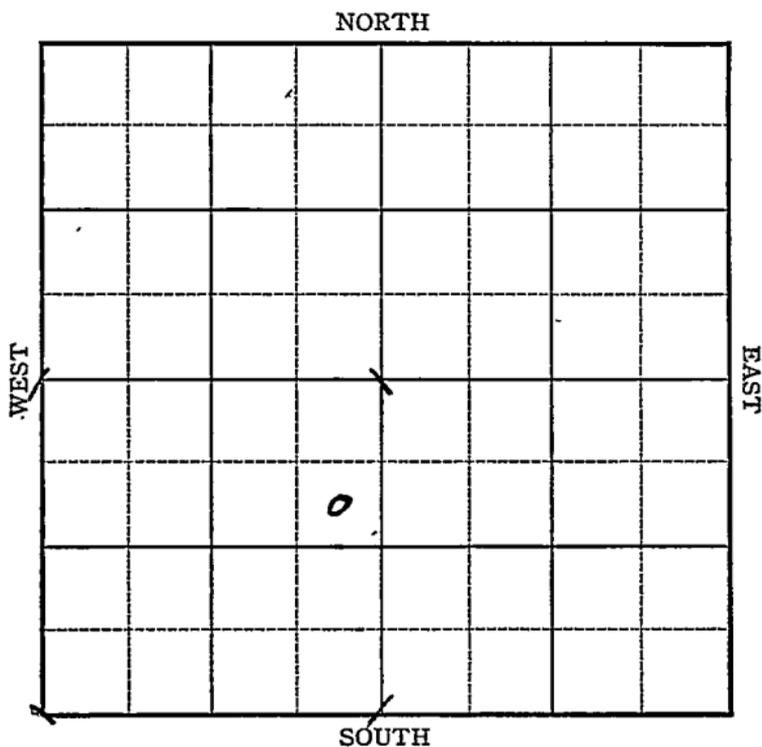

Sec. 30 Twp. 16 R. 13-W

Well No. #1 Peach "B" Farm

Armer & Vernon Company


Ainsworth

990 Ft. from N. Line

_____ Ft. from S. Line

330 Ft. from E. Line

_____ Ft. from W. Line

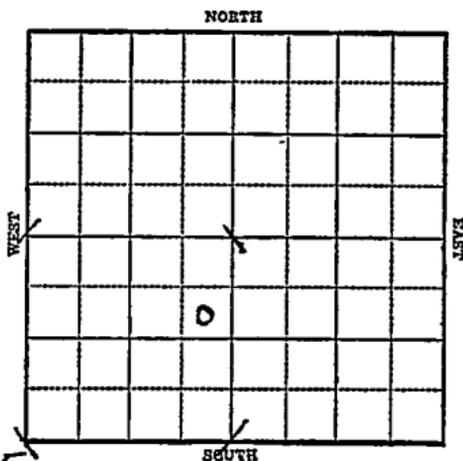

Elev. 1965

1943

R E P O R T

6/16	Cable rig.
6/23	" "
6/30	" "
7/7	" "
7/15	Drlg. 335'
7/21	12" @ 508' Anhy 938 10" @ 943
7/28	Drlg. 1150' Drlg. 2210'
8/4	Drlg. 2840 8" @ 2295'
8/11	Drlg. 3340'
8/18	7" @ 3030' Arb 3440' HFW T.D. 3466'

ABANDONED

KANSAS

Barton

Map No. 2 Sec. 30 Twp. 16 R. 13WWell No. 1 Peach "B"Armer & Vernon

Company

FIRST REPORT

Contractor

SE NE SW


SECTION PLAT

990 Ft. from N. Line

_____ Ft. from S. Line

330 Ft. from E. Line

_____ Ft. from W. Line

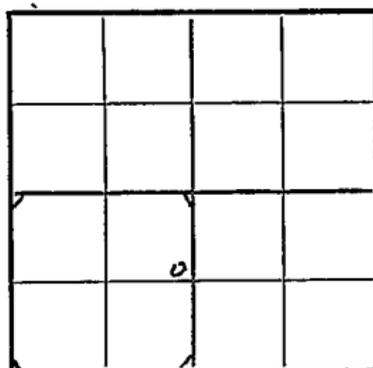

AINSWORTH POOL

Location _____

Rig up _____

Drilling and Remarks:

Cable Rig

RECORD

Cased _____ in., _____ ft.

Sand _____

Gas _____

Oil _____

Total Depth _____

PRODUCTION

1st 24 hrs. Nat. _____

1st 24 hrs. after shot _____

Gas _____ Cu. Ft.

Dry Hole _____

Abandoned _____

Date

JUN 16 1943 19

S. J. LEWIS

Scout

Barton

KANSAS

Map No. 73 Sec. 30 Twp. 16 R. 13W

Well No. 1 Peach "B"


Armer & Vernon Company

ABANDONED Contractor

SE NE SW

SECTION PLAT

990 Ft. from N. Line

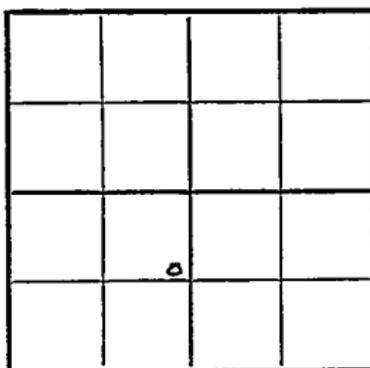

_____ Ft. from S. Line

330 Ft. from E. Line

_____ Ft. from W. Line

AINSWORTH POOL

Location _____

Rig up _____

Drilling and Remarks:

Ac 83440

HFW.

RECORD

Cased _____ in., _____ ft.

Sand _____

Gas _____

Oil _____

Total Depth 3466

PRODUCTION

1st 24 hrs. Nat. _____

1st 24 hrs. after shot _____

Gas _____ Cu. Ft.

Dry Hole _____

Abandoned _____

Date

AUG 1 8 1943 19 _____

S. J. LEWIS Scout