


Section 8 Township 16 Range 3 W

Well No. # 2 Oborg

Company Atlantic Ref.

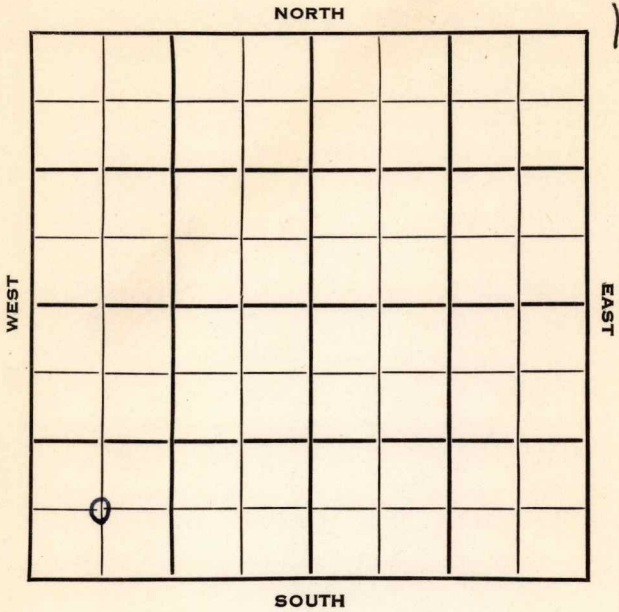

13

Sec. 8 Twp. 16 R. 3W

Well No. #2 Oborg Farm

Atlantic Ref. Company

Keating Drlg. Contractor

N. Holm Pool


Ft. from N. Line

660 Ft. from S. Line

Ft. from E. Line

660 Ft. from W. Line

C SW SW

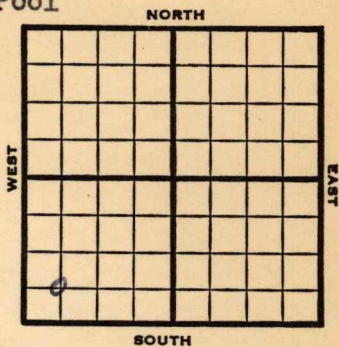

1953

Elev. 1377'

REPORT

6/3 Spud 5-29-53
8" @ 390'
Drlg 2100'

6/10 **Br. L. 2227, Lans 2293, Miss 2953, Kh 3226, Meisner 3415, Mg sho 3419 Mg Dol 3459 RTD 3462 4" @ 3460'**

6/24 CO 3462 DD 3463 S/1 BOPH 4 hrs
500 A S/4 BOPH 16 hrs. S/4 BOPH & trace of water POP

7/1 NR

7/8 NR

7/15 Spud 5-29-53
Oil well TD 3463' 8" @ 390
Br lime 2227 Lans 2293 Miss 2953' Kh. 3226 Misner 3415' Maq. sh. 3419' Maq. dol. 3459 TD 3462 4" @ 3460 CO to 3462 DD 3463 S/1 BOPH 4 hr. 500 A S/4 BOPH 16 hr. S/4 BOPH Domp. 65 BOPD 6 BW

COMPLETED

