


Section 8 Township 16 Range 3W

Well No. 3 Johnson "B"

Company Phillip & Sanderson

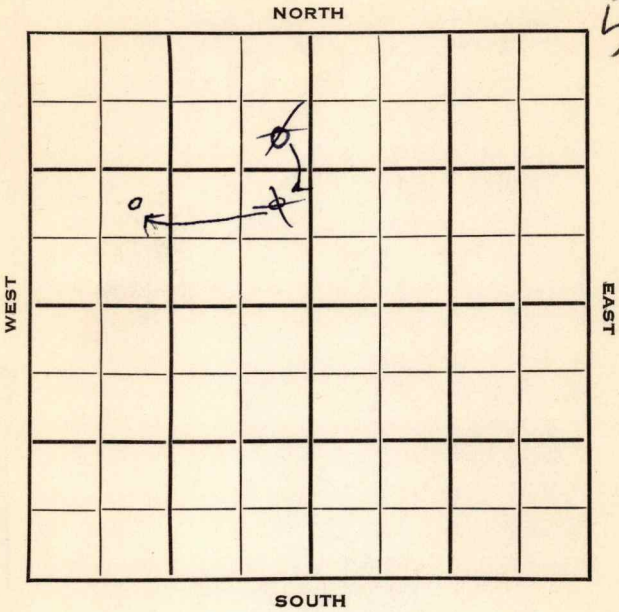

SEC.	TWP.	R.
8	16	3W

WELL NO.

#3 Johnson "B"

FARM

COMPANY

Phillips & Sanderson

CONTRACTOR

Shields

Salemsborg Pool


~~990~~ Ft. from N. Line

990 Ft. from S. Line

~~330~~ Ft. from E. Line

990 Ft. from W. Line

NE SW NW
~~NE SE NW~~
~~SE NE NW~~

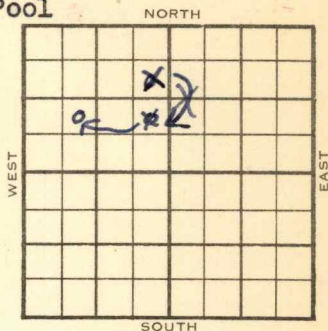

	ELEVATION	REPORT
1953	1347'	
9/16	Location	
9/23	"	
9/30	8" @ 351'	
	Drlg 1809'	
10/7	Drlg. 2510'	
10/14	Miss 2905 KH 3183 Mq Sha 3350'	
	Mq Dol 3422' RTD 3425 5" @ 3423	
10/21	NR	
10/28	Spud 9-25-53	
	Oil Well	
	TD 3425'	
	8" @ 351'	
	Miss 2905', Kh. 3183', Maq. sh. 3350',	
	Maq. dol. 3422	
	TD 3425'	
	5" @ 3423'	
	CO to 3425	
	10/3423-25, 1000A	
	S/4 $\frac{1}{2}$ boph	
	Comp. 50 BOPD	

COMPLETED

County Saline State Kansas

Sec. 8 (Blk.) 16 (Sur.) 3W Map No.

Operator Phillips & Sanderson

Well No. 3 Farm Johnson "B"

Elev. _____ Location SE NE NW

		0			
FIRST REPORT					

990 Ft. From N Line NW

330 Ft. From E Line Quarter

1st. Report SEP 16 1953

Completion _____

Remarks _____

Shields - Contr.

Spudding Date _____

Drlg. Data Salemsborg Pool

Location

Map No. _____ Sec. 8 Twp. 16 R. 3W

Well No. 3 Johnson "B"

Phillips & Sanderson Company

CORRECTION

Contractor

NE SE NW

SECTION PLAT

	o		

_____ Ft. from N. Line

990 Ft. from S. Line

330 Ft. from E. Line

_____ Ft. from W. Line

Saline County

Location _____

Rig up _____

Drilling and Remarks:

Reported
SE NE NW

RECORD

Cased _____ in., _____ ft.

Sand _____

Gas _____

Oil _____

Total Depth _____

PRODUCTION

1st 24 hrs. Nat. _____

1st 24 hrs. after shot _____

Gas _____ Cu. Ft.

Dry Hole _____

Abandoned _____

Date

SEP 23 1953 19

J. G. MCGEHEE

Scout

Map No. _____ Sec. 8 Twp. 16 R. 3W

Well No. 3 Johnson "B"

Phillips & Sanderson Company

CORRECTION

Contractor

NE SW NW

SECTION PLAT

_____ Ft. from N. Line

990 Ft. from S. Line

_____ Ft. from E. Line

990 Ft. from W. Line

0			

Saline County

Location _____

Rig up _____

Drilling and Remarks:

Recorrected from

NE SE NW

RECORD

Cased _____ in., _____ ft.

Sand _____

Gas _____

Oil _____

Total Depth _____

PRODUCTION

1st 24 hrs. Nat. _____

1st 24 hrs. after shot _____

Gas _____ Cu. Ft.

Dry Hole _____

Abandoned _____

Date

OCT 7 1959

J. G. McGEHEE

Scout

County Saline State Kansas

Sec. 8 (Blk. 16 (Sur. 3W Map No. (Twp.))

Operator Phillips & Sanderson

Well No. 3 Farm Johnson "B"

Elev. 1347 Location NE SW NW

990 Ft. From S Line NW
990 Ft. From W Line Quarter

1st. Report OCT 28 1953

Completion

Remarks Salemborg Pool
Shields - Contr.

Spudding Date 9-25-53

Drlg. Data Oil well TD 3425

8" @ 351 Miss. 2905 Kh. 3183

Maq. sh. 3350 Maq. dol. 3422 TD 3425

5" @ 3423 CO to 3425 10/ 3423-25

1000 A S/ 4 1/2 boph Comp. 50 bopd

COMPLETE