FORM 51


Saline KANSAS

Section 8 Township 16 Range 3W

Well No. #3 Oberg

Company Atlantic Ref.

14

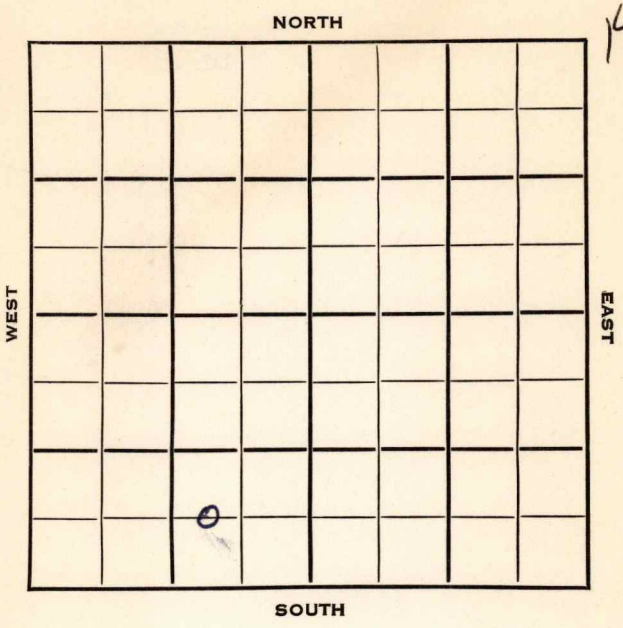

KANSAS

Saline

FORM 252-B

Sec. 8 Twp. 16 R. 3W KANSAS

Well No. #3 Oberg. Farm

Atlantic Ref. Company

Ben Brack Contractor

Salemborg Pool


Ft. from N. Line

660 Ft. from S. Line

990 Ft. from E. Line

Ft. from W. Line

C W L SE SW

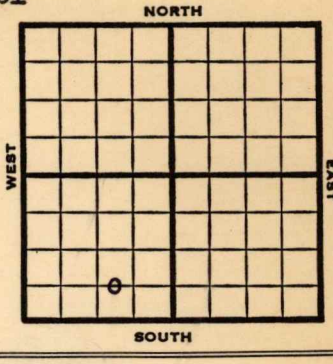

1953	Elev. 1371' REPORT
8/19 8/26	Spudding. 8" @ 397 w/150 Drlg. 2090'
9/2	Br. L. 2196, Lans 2269, Miss 2930, Kh 3201, Mg 3394, Mg Dol 3434 RTD 3436 5" @ 3434'
9/9	N.R.
9/16	NR
9/30	Spud 8-17-53 Oil well TD 3437 8" @ 397 Br lime 2196 Lans 2269 Miss 2930 Kh. 3201 Maq. 3394 Maq. dol. 3434' TD 3437 5" @ 3434 CO to 3437 10 GOPH 250 A S/1 BOPH sd-frac. S/10 BOPH 5% wtr. P/45 BOPD Comp. 75 BOPD 27 BW COMPLETED

FORM 275 FOR SALE BY KANSAS BLUE PRINT CO.

County Saline State Kansas

Sec. 8 (Blk. Twp.) 16 (Sur. Rge.) 3W Map No.

Operator Atlantic Ref.

Well No. 3 Farm Oberg

Elev. Location C WL SE SW



660 Ft. From S Line SW

990 Ft. From E Line Quarter

1st. Report AUG 19 1953

Completion

Remarks

Ben Brack - Contr.

Spudding Date

Drlg. Data Salemborg Pool

Spudding

J. G. McGEHEE

FORM 275 FOR SALE BY KANSAS BLUE PRINT CO.


County Saline State Kansas

Sec. 8 (Blk. Twp.) 16 (Sur. Rge.) 3W Map No.

Operator Atlantic Ref.

Well No. 3 Farm Oberg

Elev. 1371 Location C W L SE SW

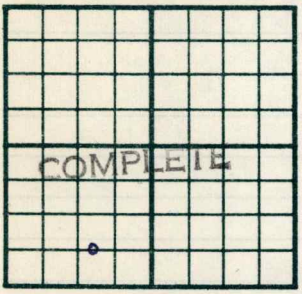

660 Ft. From S Line SW

990 Ft. From E Line Quarter

1st. Report

Completion SEP 3 0 1953

Remarks Salemborg Pool

Ben Brack - Contr.

Spudding Date 8-17-53

Drlg. Data Oil well TD 3437

8" @ 397 Br. lime 2196 Lans. 2269

Miss. 2930 Kh. 3201 Maq. 3394

Maq. dol. 3434 TD 3437 5" @ 3434

CO to 3437 10 goph 250 A S/ 1 boph

sd-frac S/ 10 boph 5% wtr. P/ 45 bopd

Comp. 75 bopd 27 bw

J. G. McGEHEE