


Section 10 Township 16 Range 3-W

Well Number 1-Othelander

Company Brouk et al

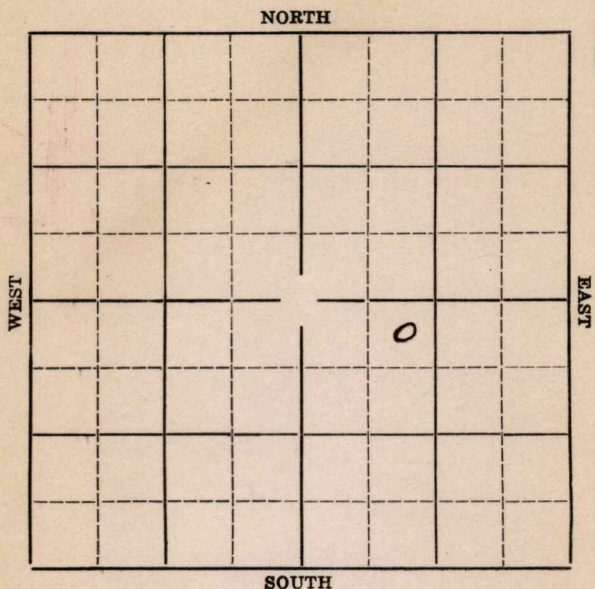

SALINE

Map No. KANSAS Sec. 10 Twp. 16 R. 3W

Well No. #1 Othelander Farm

Brouk et al Company


330' Ft. from N. Line

Ft. from S. Line

Ft. from E. Line

990' Ft. from W. Line

Elev. 1308

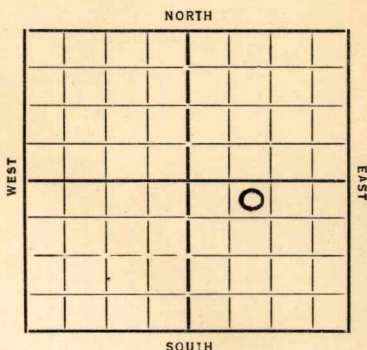

Date 1936 REPORT

5/6 Building rig.
5/14 -- 5/21--
5/28 Spud and shut down.
6/4-- 6/11--6/18--6/25--7/2--7/9--
7/16-- 7/23--~~7/30~~
7/30 Spud 190'.
8/6 15" @ 145'. Drlg. 505'.
8/13 12" @ 512'. Drlg. 1040'.
8/20 1445' fishing.
8/27 -- 9/3--
9/10 Skid rig.
9/18--~~9/24~~
9/24 Rigging up.
10/1 300' shut down.
10/8--
10/15 Drlg. 1730'.
10/22-10" @ 1873'. Drlg. 2105'.
10/29 8" @ 2310'. Drlg. 2385'.
11/6 8" @ 2440 T. D. 2455
Under ream 8"
11/12 2650 Shut down.

OVER

1936

11/19-- Shut down 2650'.

11/27 8" @ 2596'. Drlg. 2800'.

12/3 6" @ 2810'. Miss. L. 2815'.

Water 2845-60'. 6" @ 2967'.

Drlg. 3004'.

12/10 Viola 3294'. Estimated 5 bbls
oil. Drlg. 3400'.

12/17 Base Viola 3440'.

Wilcox 3493'. Sil. 3520'.

T. D. 3525'. Shut down.

12/24 P. B. 3440'. 1000 acid.
No test.

12/29 P. B. 3320'. 5" @ 3288'
(Corrected)

1700' oil in hole 4 days.

1937

1/7 1000 acid. Swabbed 27 bbls. oil
8 hrs. show water.

1/14 2000 acid. No test.

1/20 Sil. 3520'. T. D. 3525'.

P. B. 3320'. 4000 acid.

15 oil 1 water 4 hrs.

pumped off. D & A

ABANDONED

KANSAS

Map No. 42 Sec. 10 Twp. 16 R. 3W.Well No. 1 Otheland etBrouk & Co. Company

Contractor

SECTION PLAT

		0	

380 Ft. from N. Line

_____ Ft. from S. Line

_____ Ft. from E. Line

990 Ft. from W. Line

ABANDONED

RECORD

Location _____

Cased _____ in., _____ ft.

Rig up _____

Sand _____

Drilling and Remarks:

Gas _____

Oil _____

Total Depth 9525

PRODUCTION

1st 24 hrs. Nat. _____

1st 24 hrs. after shot _____

Gas _____ Cu. Ft.

Dry Hole _____

Abandoned _____

Date

JAN 20 1937 19

S. J. LEWIS Scout

KANSAS

Map No. 42 Sec. 10 Twp. 16 R. 3NWell No. 1 Other landerBrunk & Sons Company

Contractor

SECTION PLAT

330 Ft. from N. Line

Ft. from S. Line

Ft. from E. Line

990 Ft. from W. Line

		0	

FIRST REPORT

Location

Rig up

Drilling and Remarks:

Building rig

RECORD

Cased in., ft.

Sand

Gas

Oil

Total Depth

PRODUCTION

1st 24 hrs. Nat.

1st 24 hrs. after shot

Gas Cu. Ft.

Dry Hole

Abandoned

Date

MAY 6 1936 192

S. J. LEWIS

Scout